


BGA ZONE 45 BGA ZONE 44

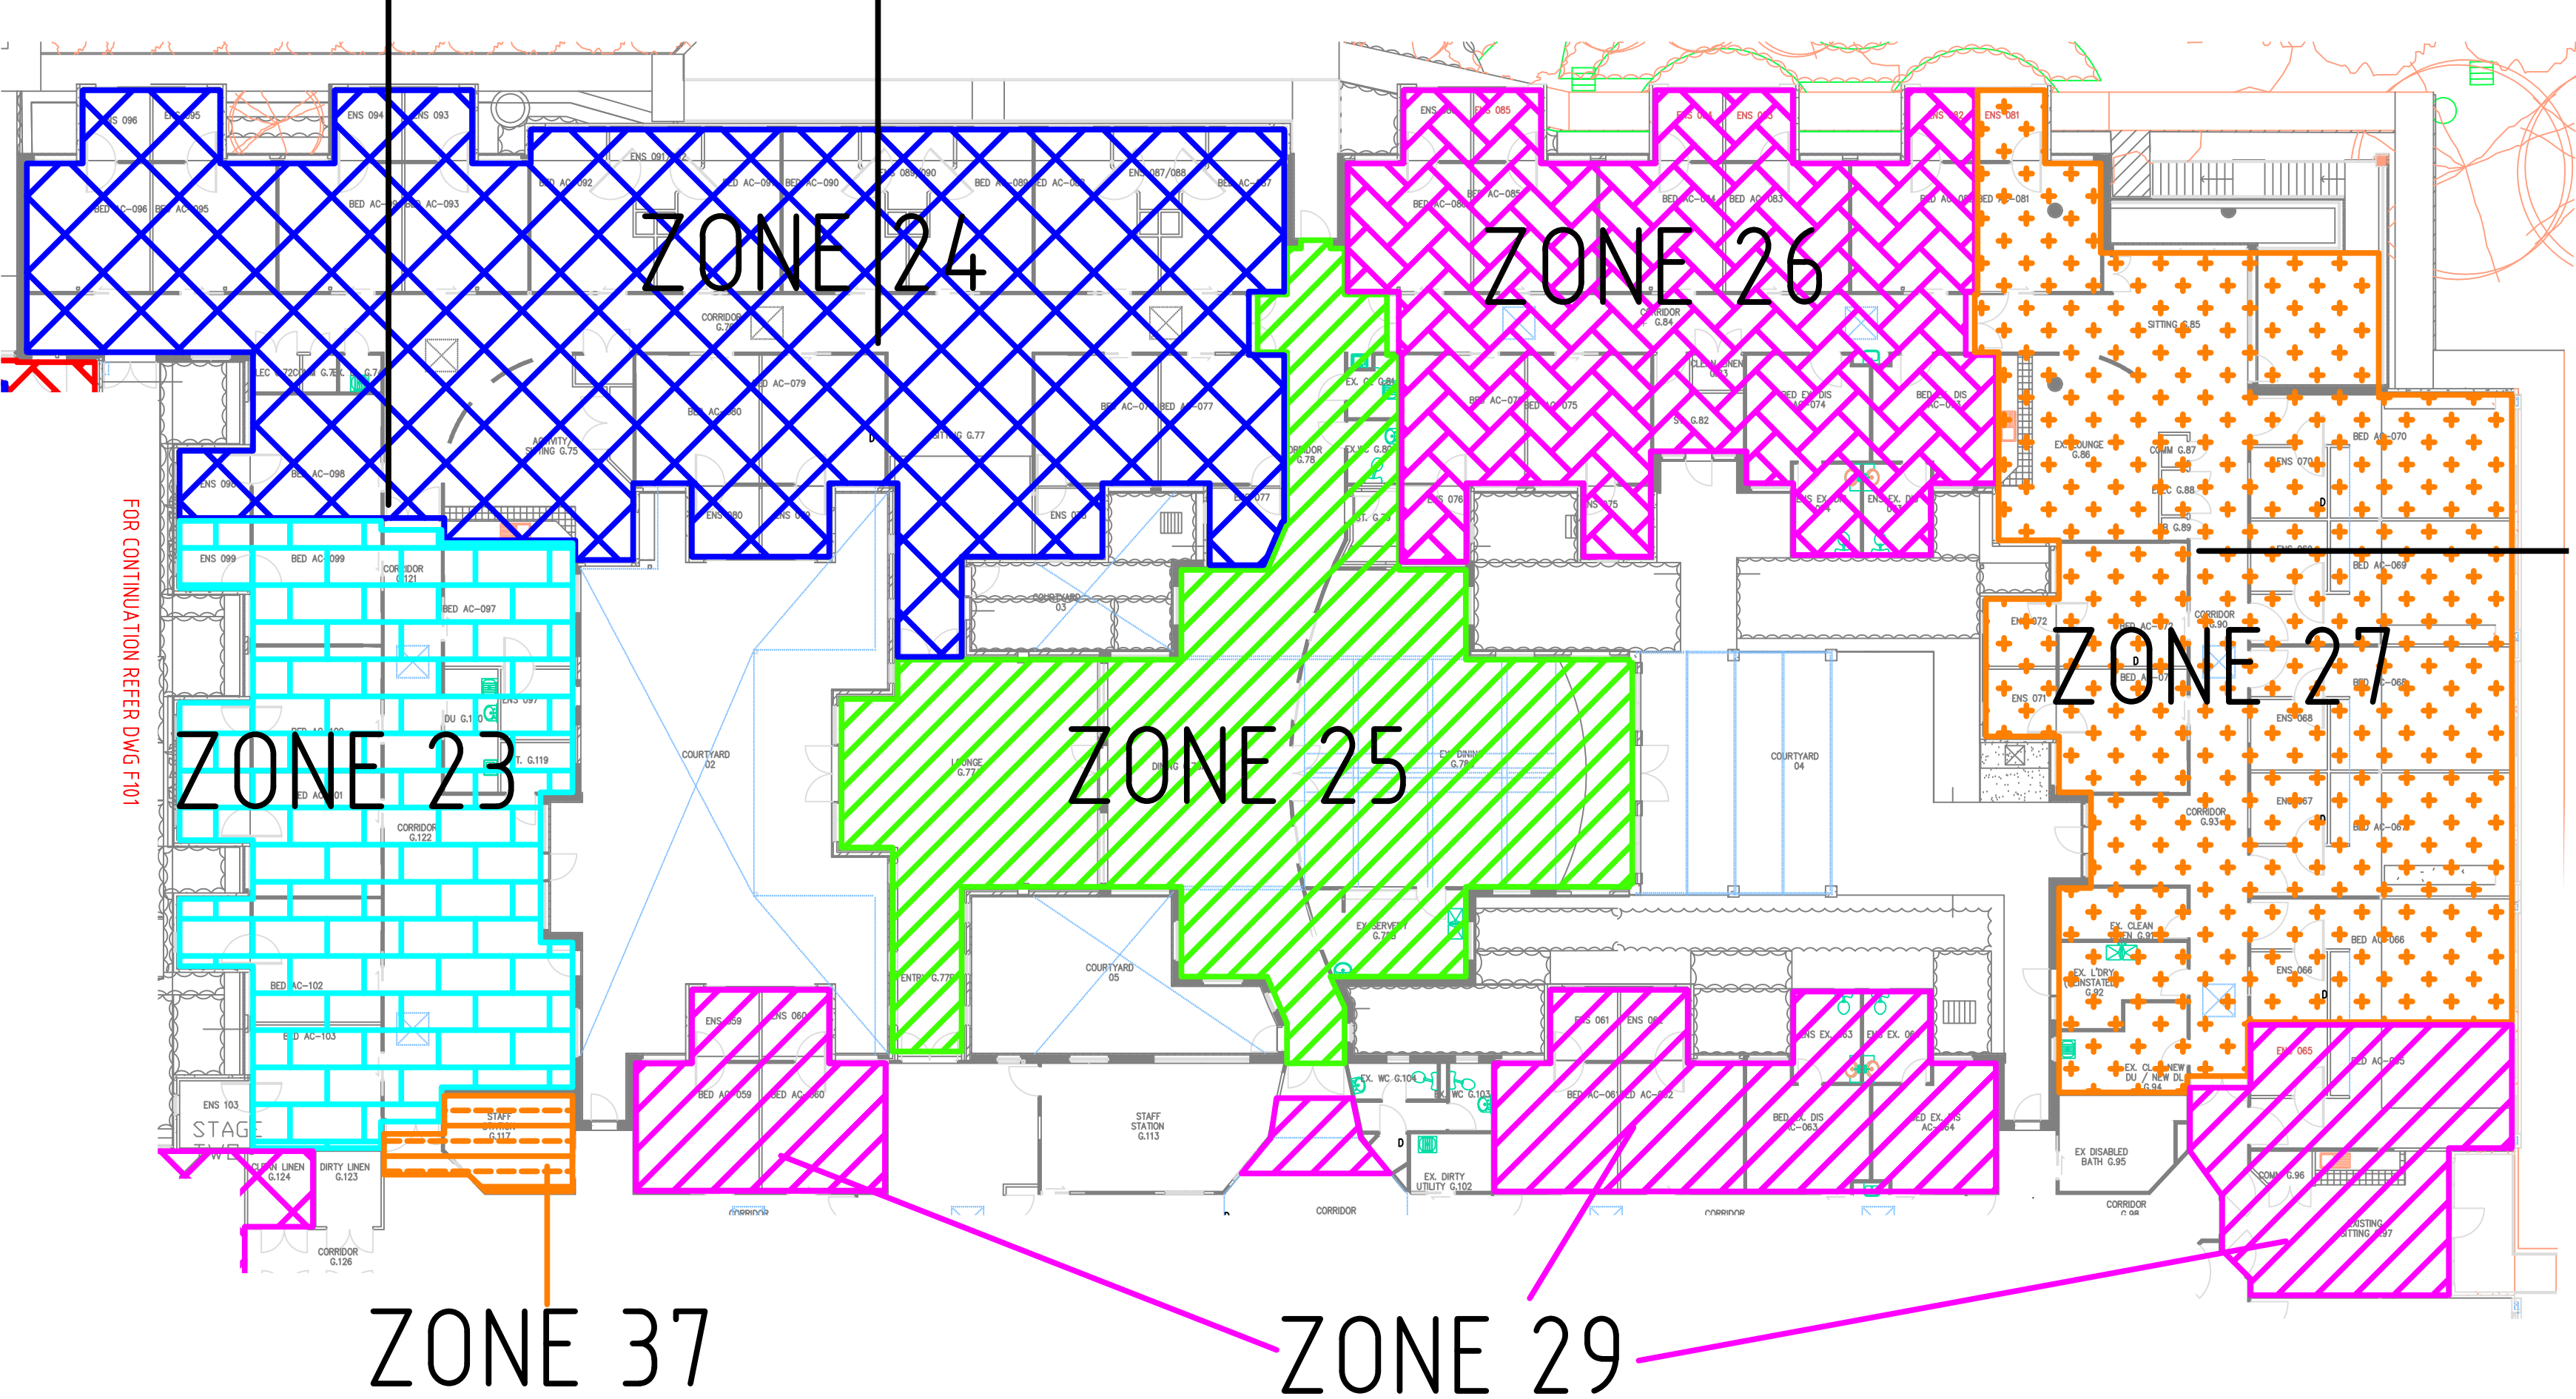

BGA ZONE
GENERAL NOTES:
43

Rev	Description	Checked	Date
B			
C			
D			

Proj Date	X08-AGED	14.11.11	X00-SITE
14.11.11	X06-AGED	DD.MM.YY	###-ARC
14.11.11	X01-AGED	DD.MM.YY	###-ARC
14.11.11	X00-AGED	DD.MM.YY	###-ARC

Architect	ThomsonAdsett
Level 1	242 Dorcas Street
	South Melbourne
VIC 3205	Phone: (03) 9588 8170
	Fax: (03) 9588 8171
	Email: info@thomsonadsett.com.au
	www.thomsonadsett.com.au

Project	ASSISI CENTRE
	EXISTING AGED CARE BUILDING &
	NEW RETIREMENT ACCOMMODATION
	230 ROSANNA RD, ROSANNA

Title	
-------	--

Drawn	Date
Checked	Scale
	Job No

Drawing No	Revision
------------	----------

OWS AS BUILT

TENDERERS
SHALL VISIT SITE
PRIOR TO TENDER

