

FRONT DOOR

MSSB 3

LAMP TEST
POWER AVAILABLE
FIRE MODE
HHW P-3
HHW P-4
BOILER-2

P/B
Y
R
G R
G R
G R
ACM
ACM
ON/OFF

FLUE EXH
G R
AM

MSSB 3 CONTROL PANNEL IP 54

CABLE DUCT

CIRCUIT BREAKERS

MAIN ISOLATOR
HHW P-1
HHW P-2
CONTROL
AUTO FILL
BOILER
FLUE EXH

LOW VOLTAGE TERMINALS

CABLE DUCT

24V CB
24V AC TRANSFORMER
DDC 4
KWHR METER

CABLE DUCT

GFA
R1
R2
C1
C2

CABLE DUCT

600mm

Client	J.B.K.	Contact	Steve	Drawn by	N.R.	Date	24/03/14	Rev. no.	2
ASSISI CENTRE 230 ROSANNA ROAD, ROSANNA				MSSB 3 Page 5 of 6 AS BUILT					
D.C Temperature Controls				Email d.p.duncan@bigpond.com PH 0412 389 460					

Produced using circuitwiz-

FRONT DOOR

MSSB 3

LAMP TEST
POWER AVAILABLE
FIRE MODE
HHW P-3
HHW P-4
BOILER-2

P/B
Y
R
G R
G R
G R
ACM
ACM
ON/OFF

FLUE EXH
G R
AM

MSSB 3 CONTROL PANNEL IP 54

CABLE DUCT

CIRCUIT BREAKERS

MAIN ISOLATOR
HHW P-1
HHW P-2
CONTROL
AUTO FILL
BOILER
FLUE EXH

LOW VOLTAGE TERMINALS

CABLE DUCT

24V CB
24V AC TRANSFORMER
DDC 4
KWHR METER

CABLE DUCT



GFA
R1
R2
C1
C2

CABLE DUCT

600mm

Client	J.B.K.	Contact	Steve	Drawn by	N.R.	Date	24/03/14	Rev. no.	2
ASSISI CENTRE 230 ROSANNA ROAD, ROSANNA				MSSB 3 Page 5 of 6 AS BUILT					
D.C Temperature Controls				Email d.p.duncan@bigpond.com PH 0412 389 460					

Produced using circuitwiz-

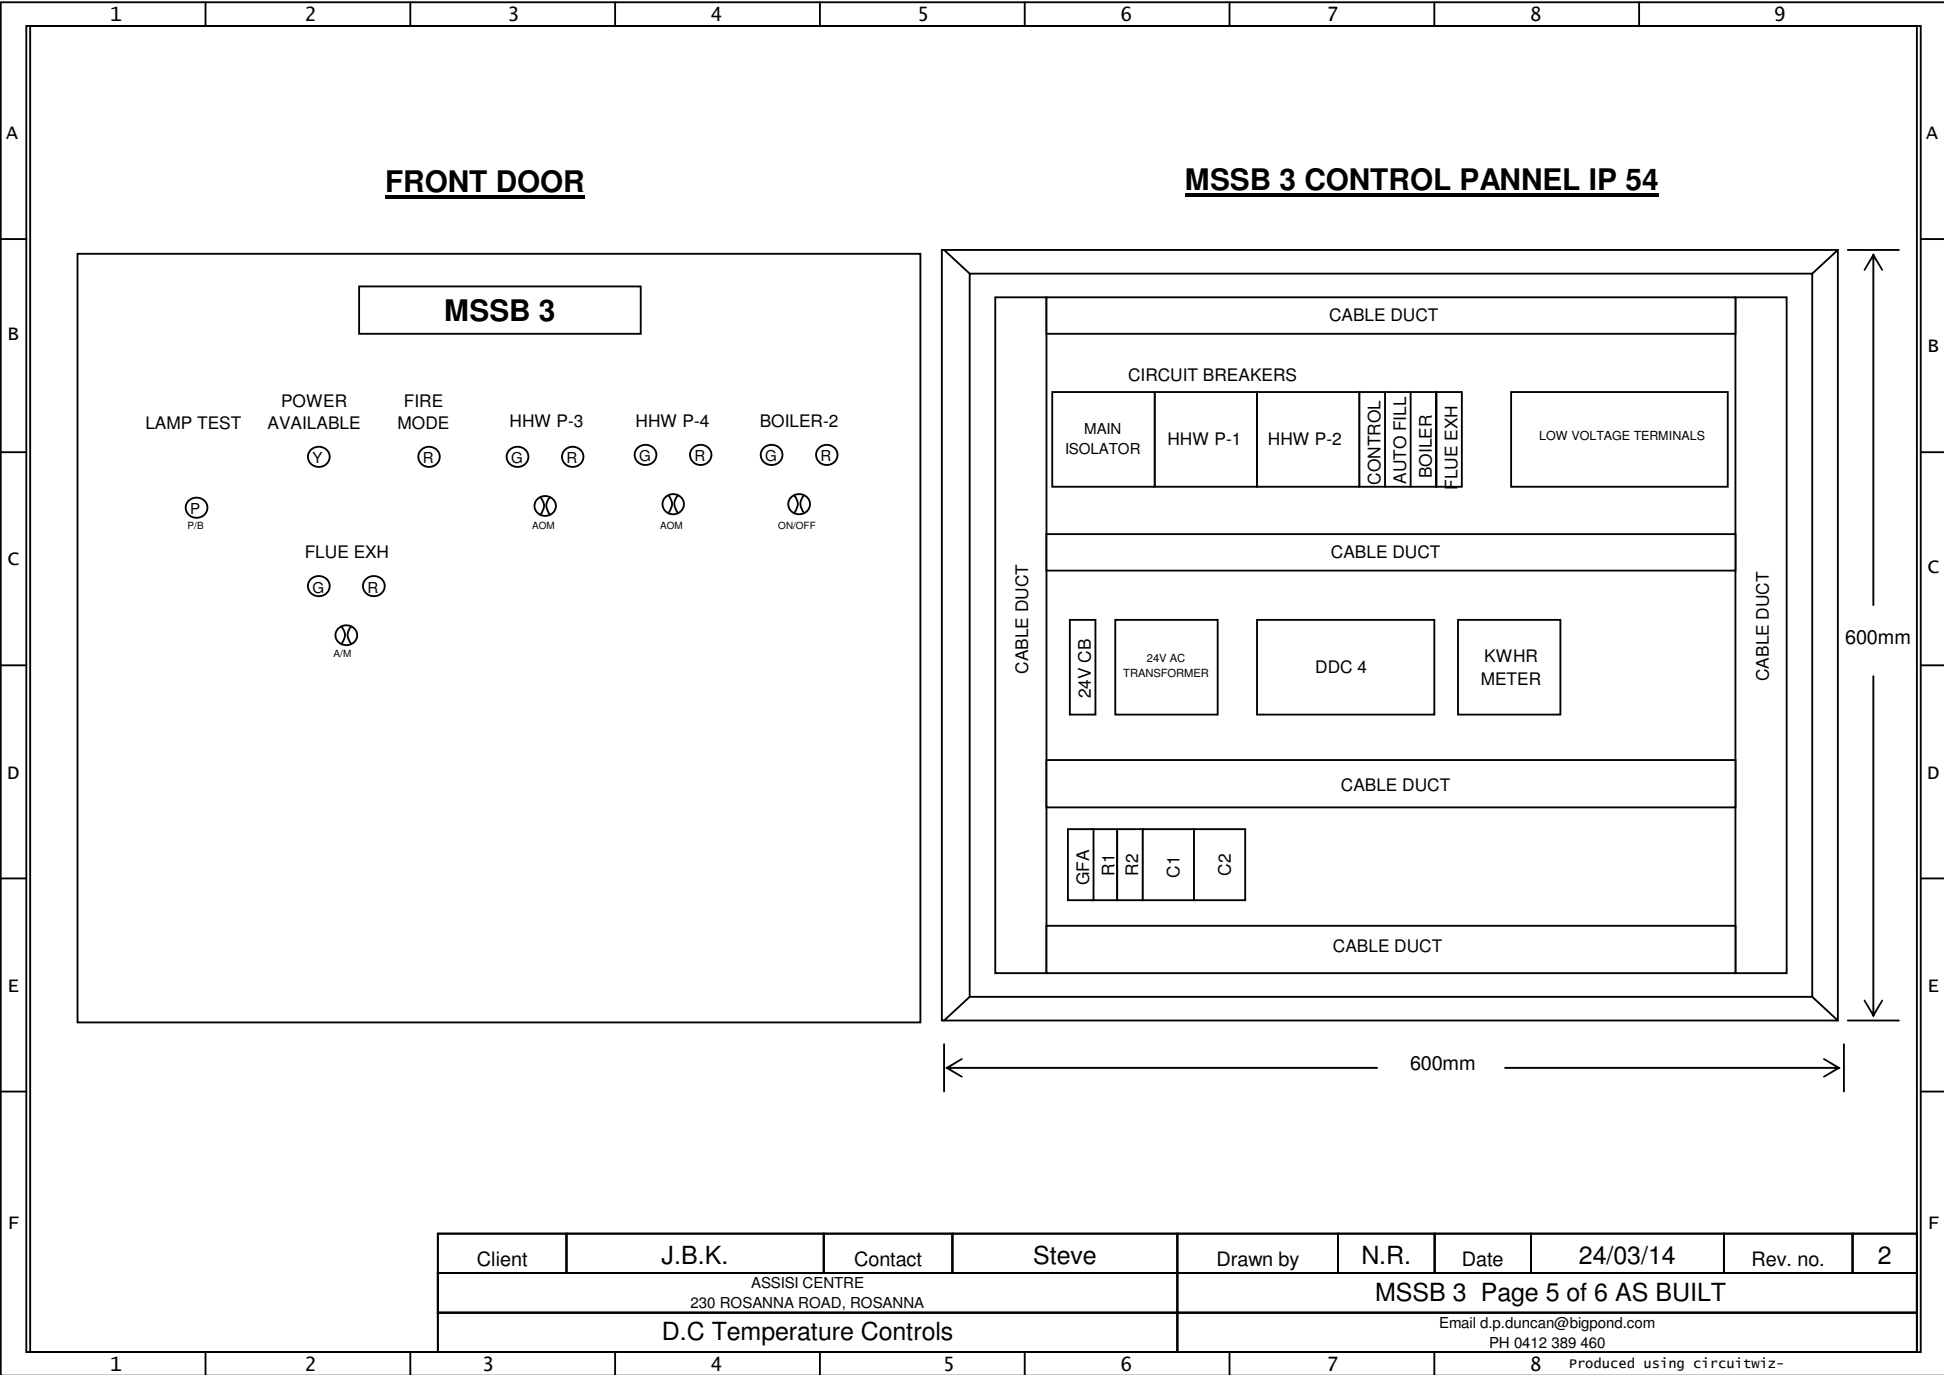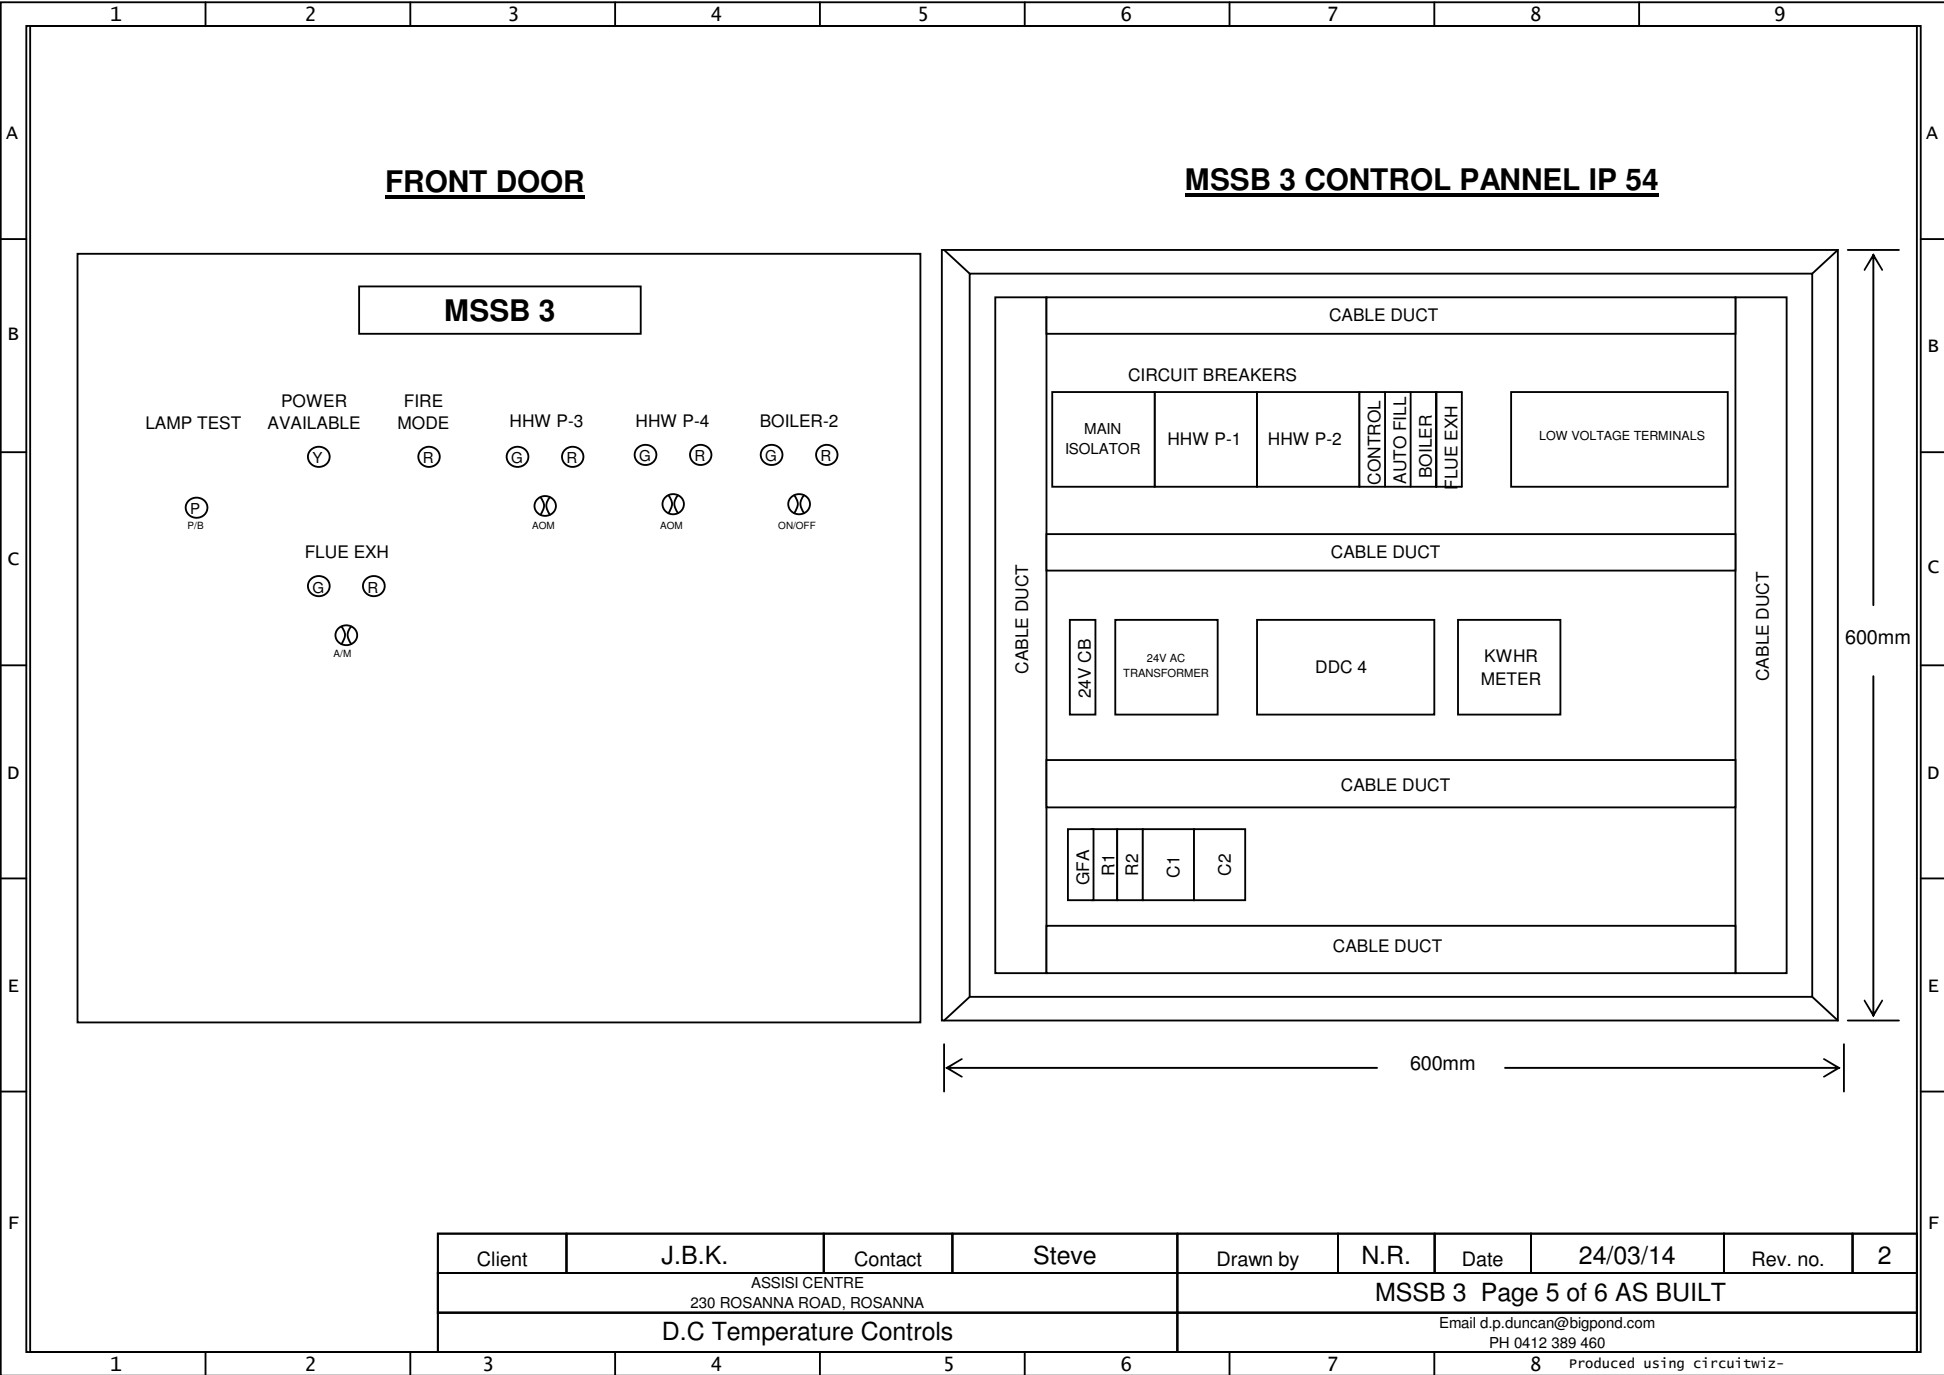

1 2 3 4 5 6 7 8 9

A

FRONT DOOR

MSSB 3

LAMP TEST POWER AVAILABLE FIRE MODE HHW P-3 HHW P-4 BOILER-2

PIB

FLUE EXH

ACM

ACM

ON/OFF

MSSB 3 CONTROL PANNEL IP 54

CIRCUIT BREAKERS

MAIN ISOLATOR HHW P-1 HHW P-2 CONTROL AUTO FILL BOILER FLUE EXH

LOW VOLTAGE TERMINALS

CABLE DUCT

24V CB

24V AC TRANSFORMER

DDC 4

KWHR METER

CABLE DUCT

GFA R1 R2 C1 C2

600mm

600mm

Client	J.B.K.	Contact	Steve	Drawn by	N.R.	Date	24/03/14	Rev. no.	2
ASSISI CENTRE 230 ROSANNA ROAD, ROSANNA				MSSB 3 Page 5 of 6 AS BUILT					
D.C Temperature Controls				Email d.p.duncan@bigpond.com PH 0412 389 460					

1 2 3 4 5 6 7 8 9

F

Produced using circuitwiz-

	1	2	3	4	5	6	7	8	9											
A	EQUIPMENT SCHEDULE									A										
B	MAIN ISOLATOR				MOELLER 63A IS-63/3					B										
	PHASE FAILURE CONTROLER				TIGER TIG-RSTC															
	KILOWATT HOUR METER				TIGER TPKWH-100D															
	CIRCUIT BREAKER				MOELLER															
	CONTROL TRANSFORMER				ALTRO															
	CONTROL RELAYS				TIGER															
	CONTROL SWITCH'S				MOELLER															
	CONTACTORS				MOELLER															
C	OVERLOADS				MOELLER					C										
	PILOT LIGHTS				DDN AUSTRALIA PL22-22BS															
	LAMP TEST				TIGER LT-20															
	DDC				INNOTECH MAXIUM 2															
	SPEED DRIVES				ROTOR TECH / ZENER															
	SWITCH BOARD				EUREKA EEST6-620															
D										D										
E										E										
F										F										
	Client		J.B.K.		Contact		Steve		Drawn by		N.R.		Date		24/03/14		Rev. no.		2	
	ASSISI CENTRE 230 ROSANNA ROAD, ROSANNA									MSSB 3 Page 6 of 6 AS BUILT										
	D.C Temperature Controls									Email d.p.duncan@bigpond.com PH 0412 389 460										
	1	2	3	4	5	6	7	8	Produced using circuitwiz-											

Client	J.B.K.	Contact	Steve	Drawn by	N.R.	Date	24/03/14	Rev. no.	2
ASSISI CENTRE 230 ROSANNA ROAD, ROSANNA				MSSB 3 Page 6 of 6 AS BUILT					
D.C Temperature Controls				Email d.p.duncan@bigpond.com PH 0412 389 460					