



Client	J.B.K.	Contact	Steve	Drawn by	N.R.	Date	24/03/14	Rev. no.	2
ASSISI CENTRE 230 ROSANNA ROAD, ROSANNA				MSSB 7 Page 6 of 9 AS BUILT					
D.C Temperature Controls				Email d.p.duncan@bigpond.com PH 0412 389 460					

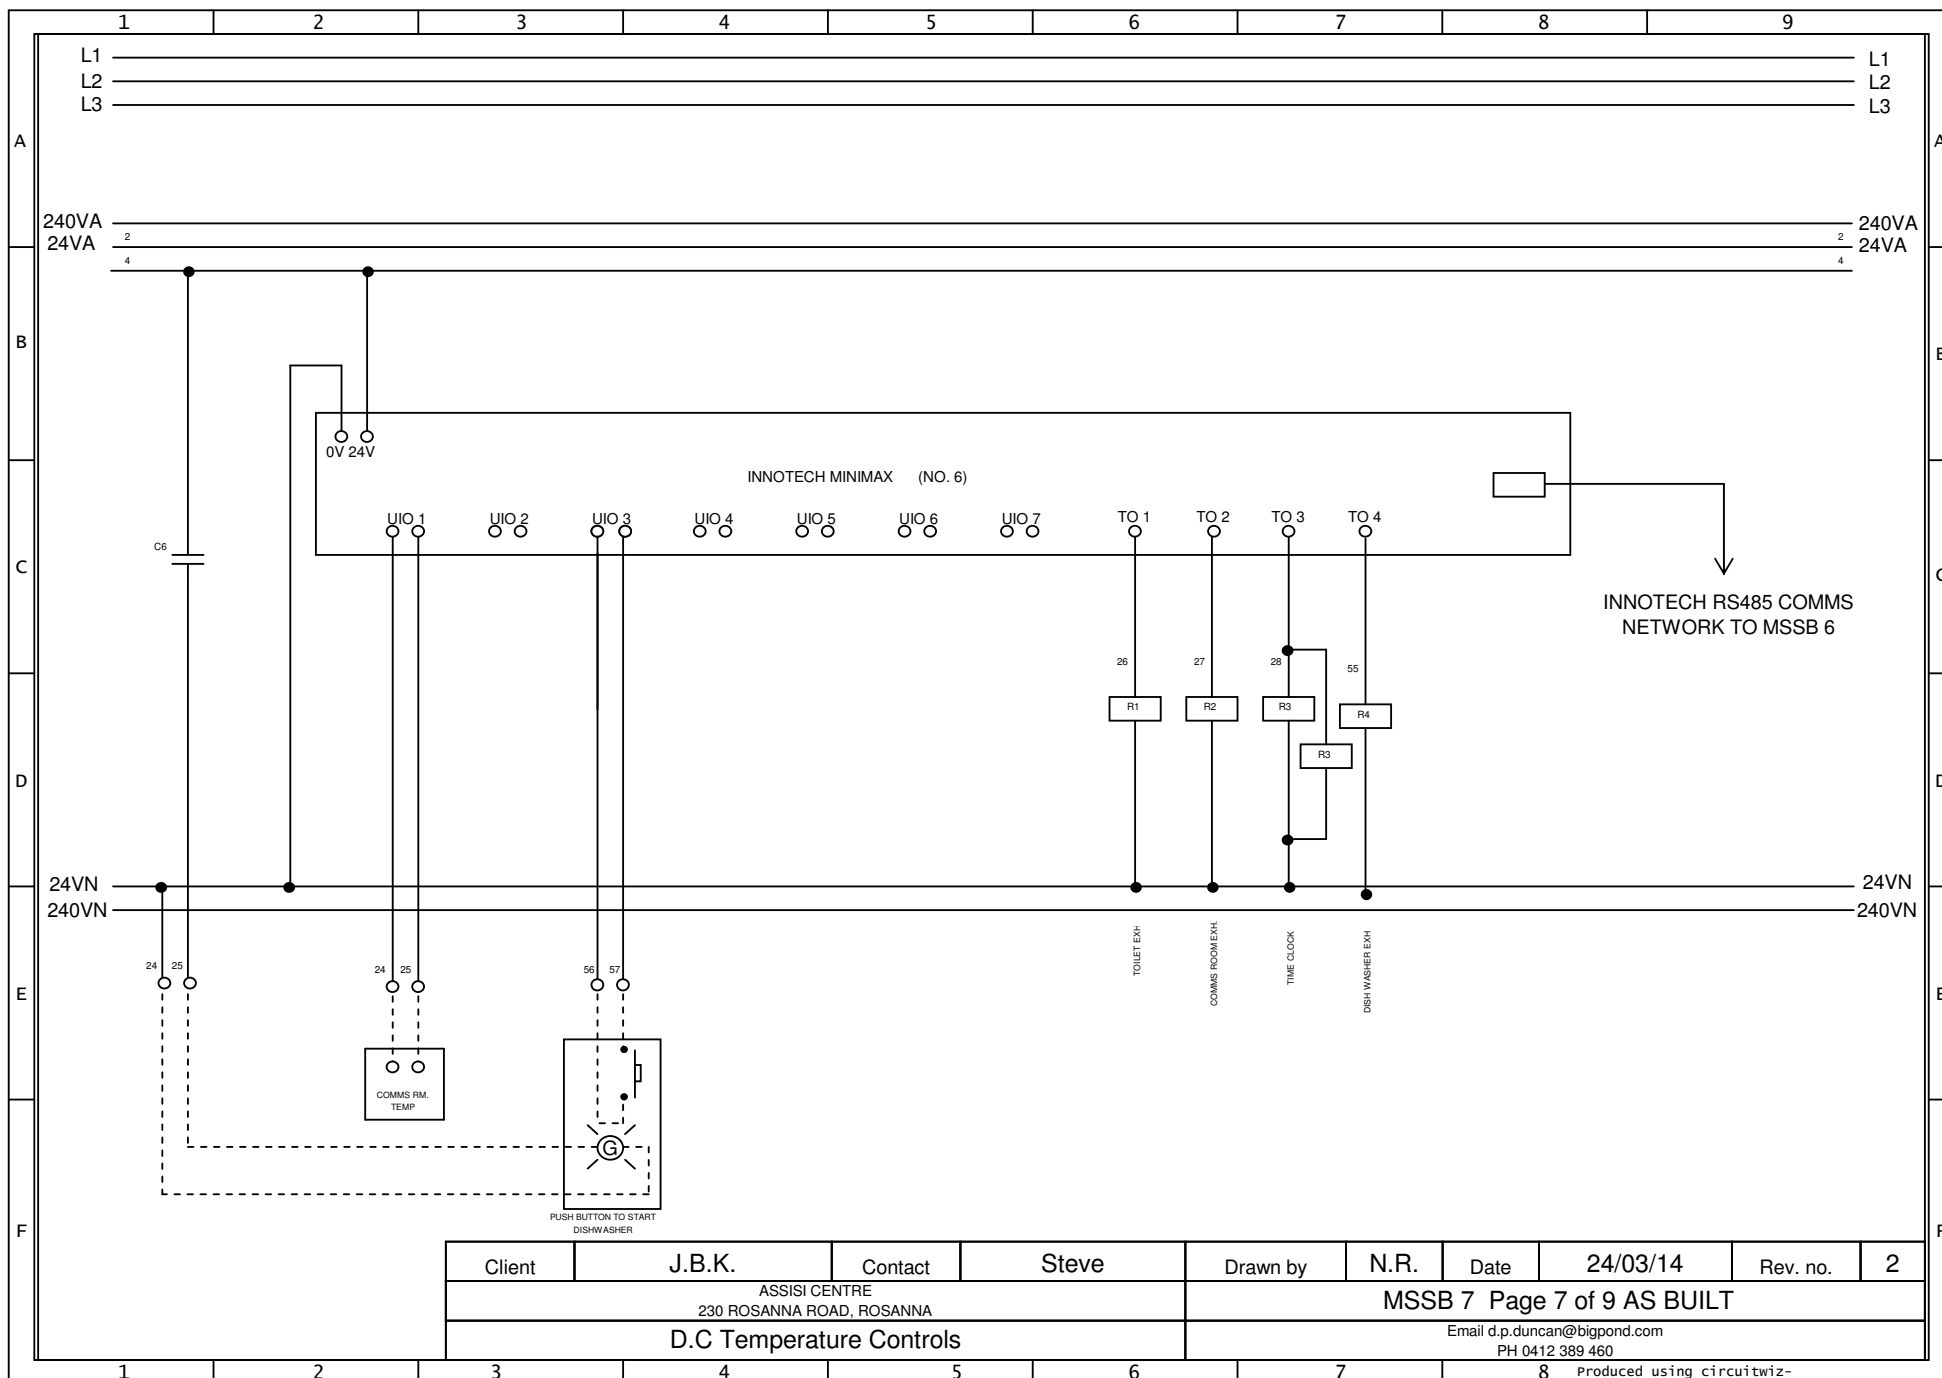

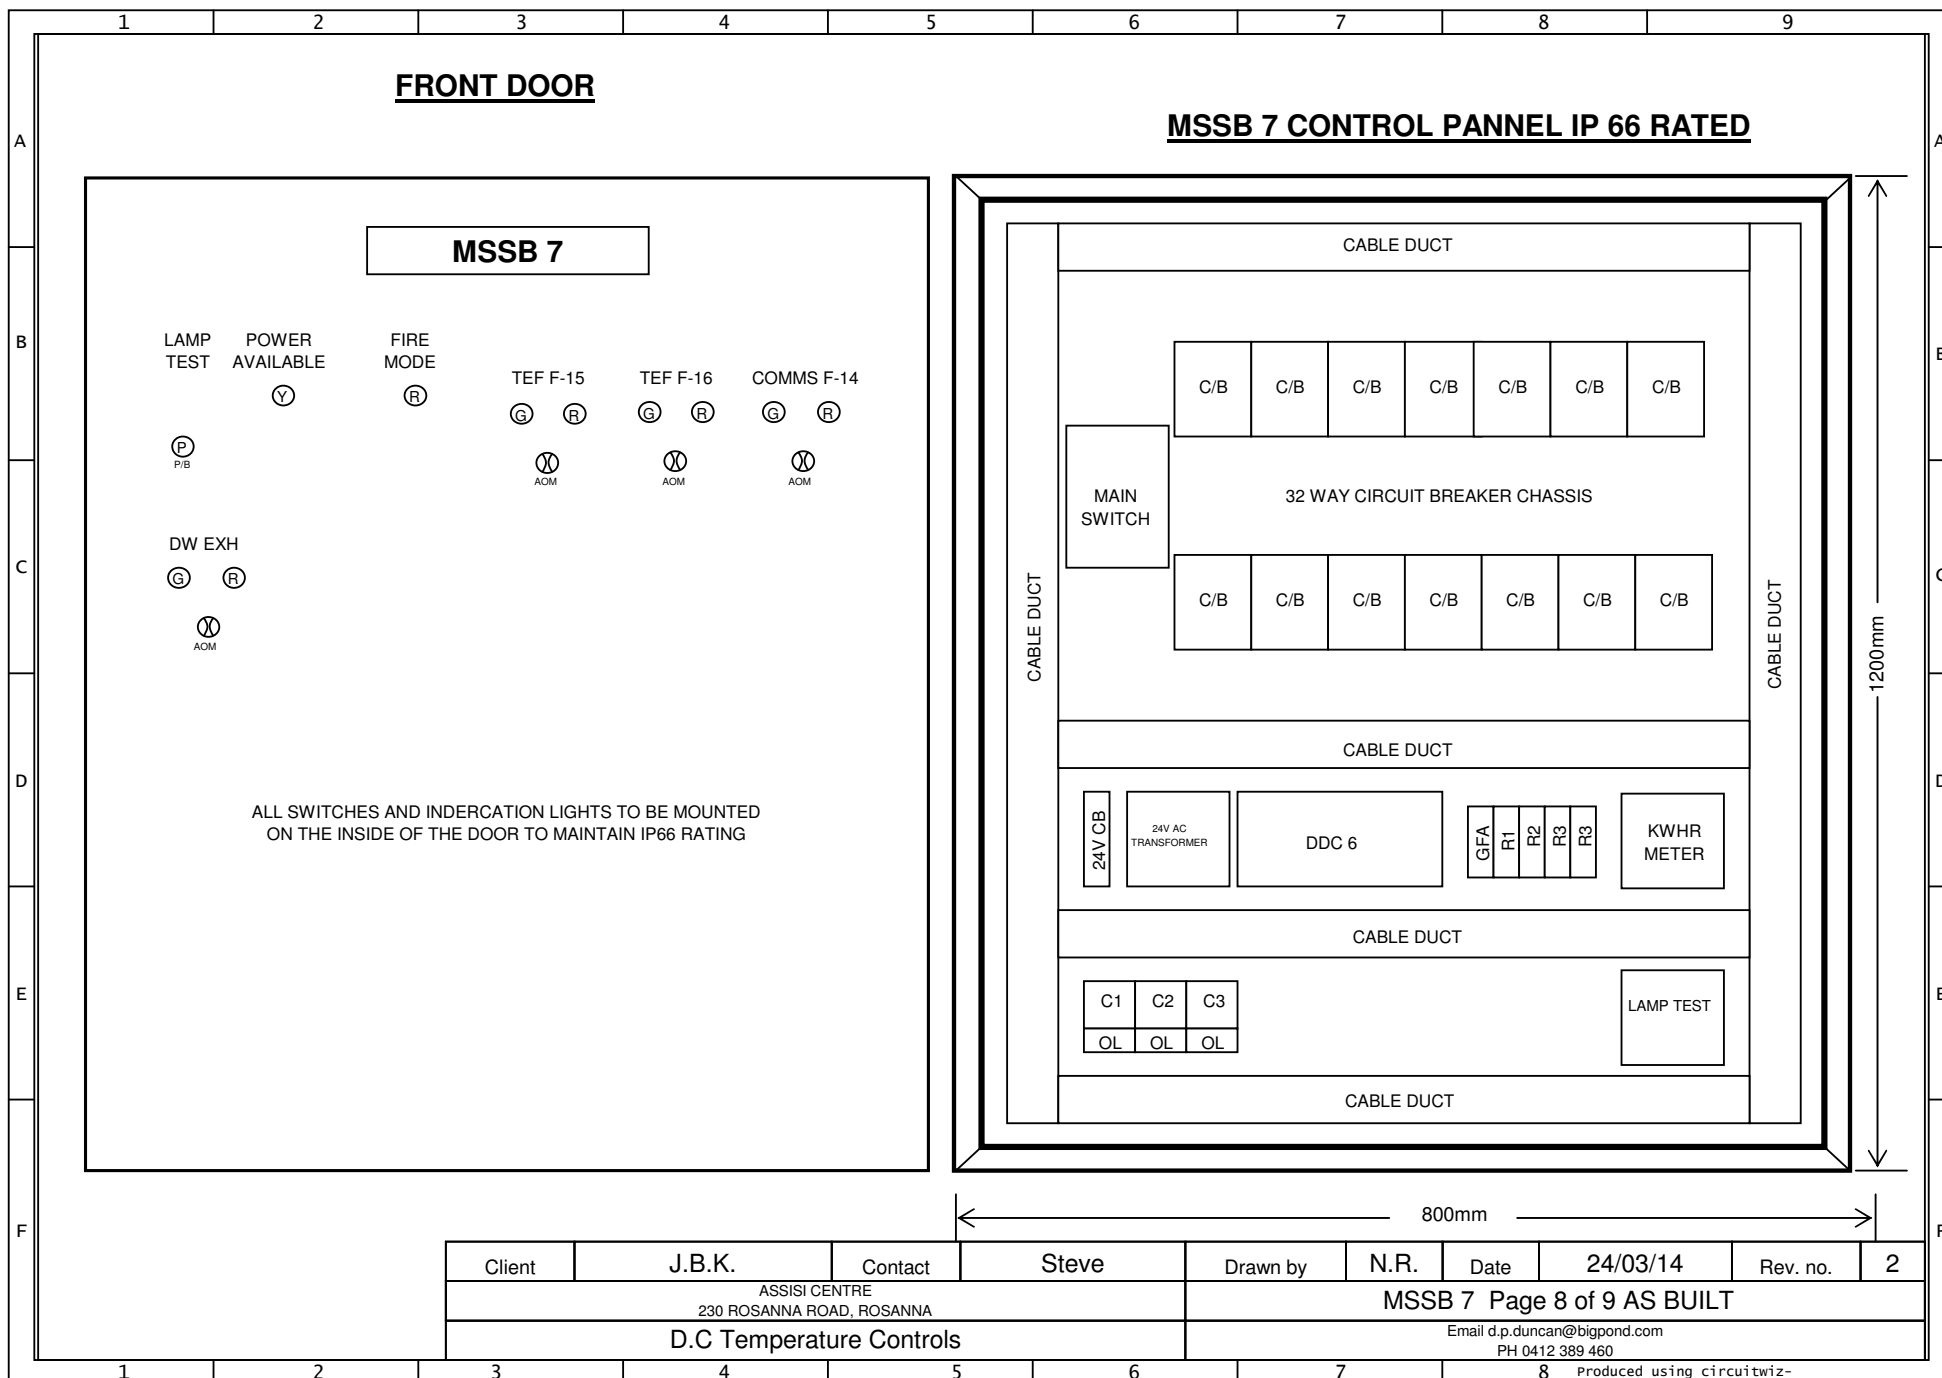

	1	2	3	4	5	6	7	8	9											
A	EQUIPMENT SCHEDULE									A										
B	MAIN ISOLATOR				C&S CSSD250D1 24KA					B										
	PHASE FAILURE CONTROLER				TIGER TIG-RSTC															
	KILOWATT HOUR METER				TIGER TPKWH-100D															
	CIRCUIT BREAKER				MOELLER															
	CONTROL TRANSFORMER				ALTRO															
	CONTROL RELAYS				TIGER															
	CONTROL SWITCH'S				MOELLER															
	CONTACTORS				MOELLER															
C	OVERLOADS				MOELLER					C										
	PILOT LIGHTS				DDN AUSTRALIA PL22-22BS															
	LAMP TEST				TIGER LT-20															
	DDC				INNOTECH MINIMAX															
	SPEED CONTROLLER				VA2.0 & VA2.8 POT															
D	SWITCH BOARD				EUREKA EEST8-830					D										
E										E										
F										F										
	Client		J.B.K.		Contact		Steve		Drawn by		N.R.		Date		24/03/14		Rev. no.		2	
	ASSISI CENTRE 230 ROSANNA ROAD, ROSANNA									MSSB 7 Page 9 of 9 AS BUILT										
	D.C Temperature Controls									Email d.p.duncan@bigpond.com PH 0412 389 460										
	1	2	3	4	5	6	7	8	Produced using circuitwiz-											

Client	J.B.K.	Contact	Steve	Drawn by	N.R.	Date	24/03/14	Rev. no.	2
ASSISI CENTRE 230 ROSANNA ROAD, ROSANNA				MSSB 7 Page 9 of 9 AS BUILT					
D.C Temperature Controls				Email d.p.duncan@bigpond.com PH 0412 389 460					