

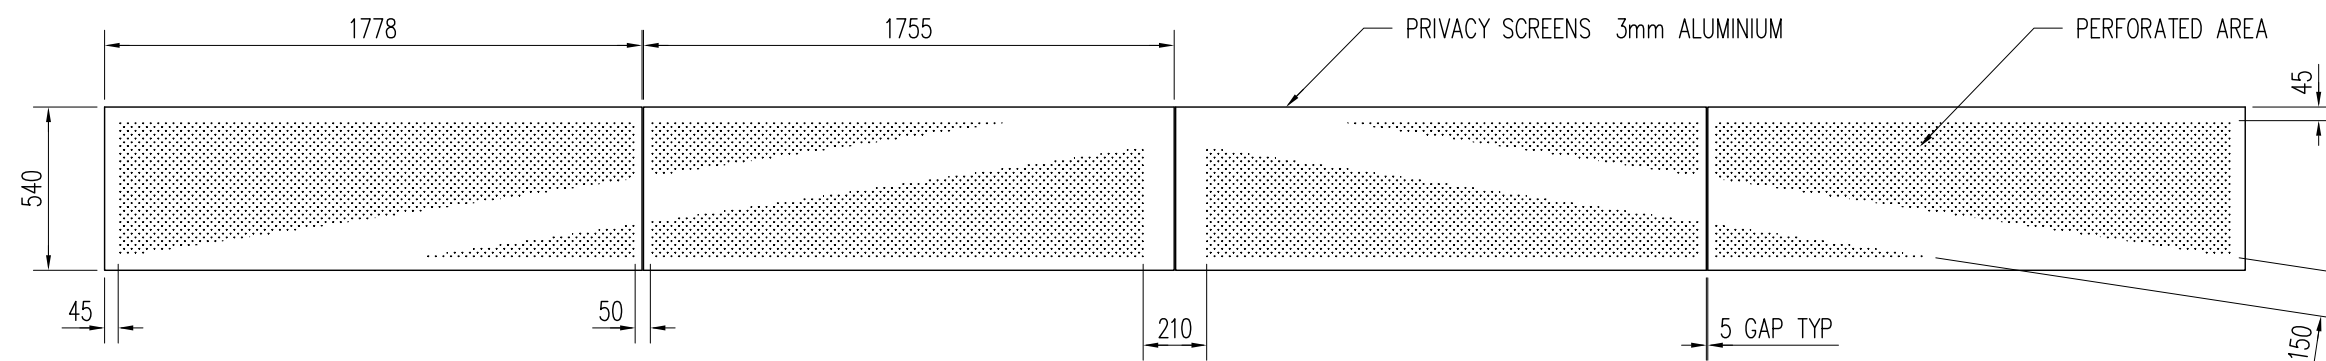


SCREEN ASSEMBLY
SCALE 1:25

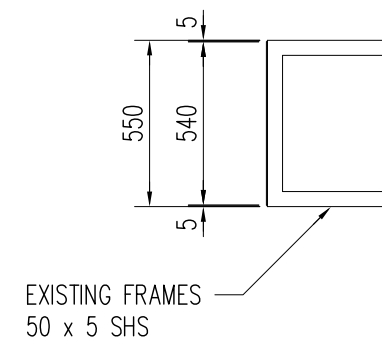

PERFORATION ORIENTATION
SCALE 1:25

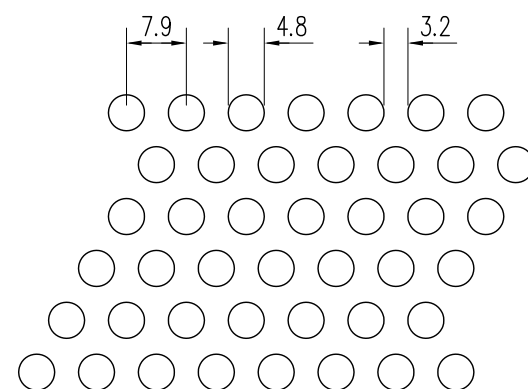

PERFORATION PATTERN
LOCKER R04833 4.76mm-33%

FINISH TO BE POWDERCOATED

ALL DATA DISCLOSED HERIN IS THE PROPERTY OF LOWLINE Pty AND MAY NOT BE USED FOR MANUFACTURE, PROCUREMENT OR DISCLOSURE WITHOUT THE PERMISSION OF THE OWNERS.

No.	REVISION	DRAWN	DATE

LOWLINE
GROUP

11 WILLIAM STREET. BLACKSTONE. QUEENSLAND.
PO Box 486 BOOVAL. 4304. Ph. 07 3816 5600.

SCALE 1:25	PROJECT - 14511
DRAWN	R.BRITTON 11-09-13
CHECKED	-
DESIGNED	-
APPROVED	

ASSISI REDEVELOPMENT
POLARIS SCREENS
GENERAL ASSEMBLY

DRAWING No.	A3
F420-001	
ProCAD AUSTRALIA	
ISSUE	