


ALL DATA DISCLOSED HEREIN IS THE PROPERTY OF LOWLINE GROUP & MAY NOT BE USED FOR MANUFACTURE, PROCUREMENT OR DISCLOSURE WITHOUT THE PERMISSION OF THE OWNERS.

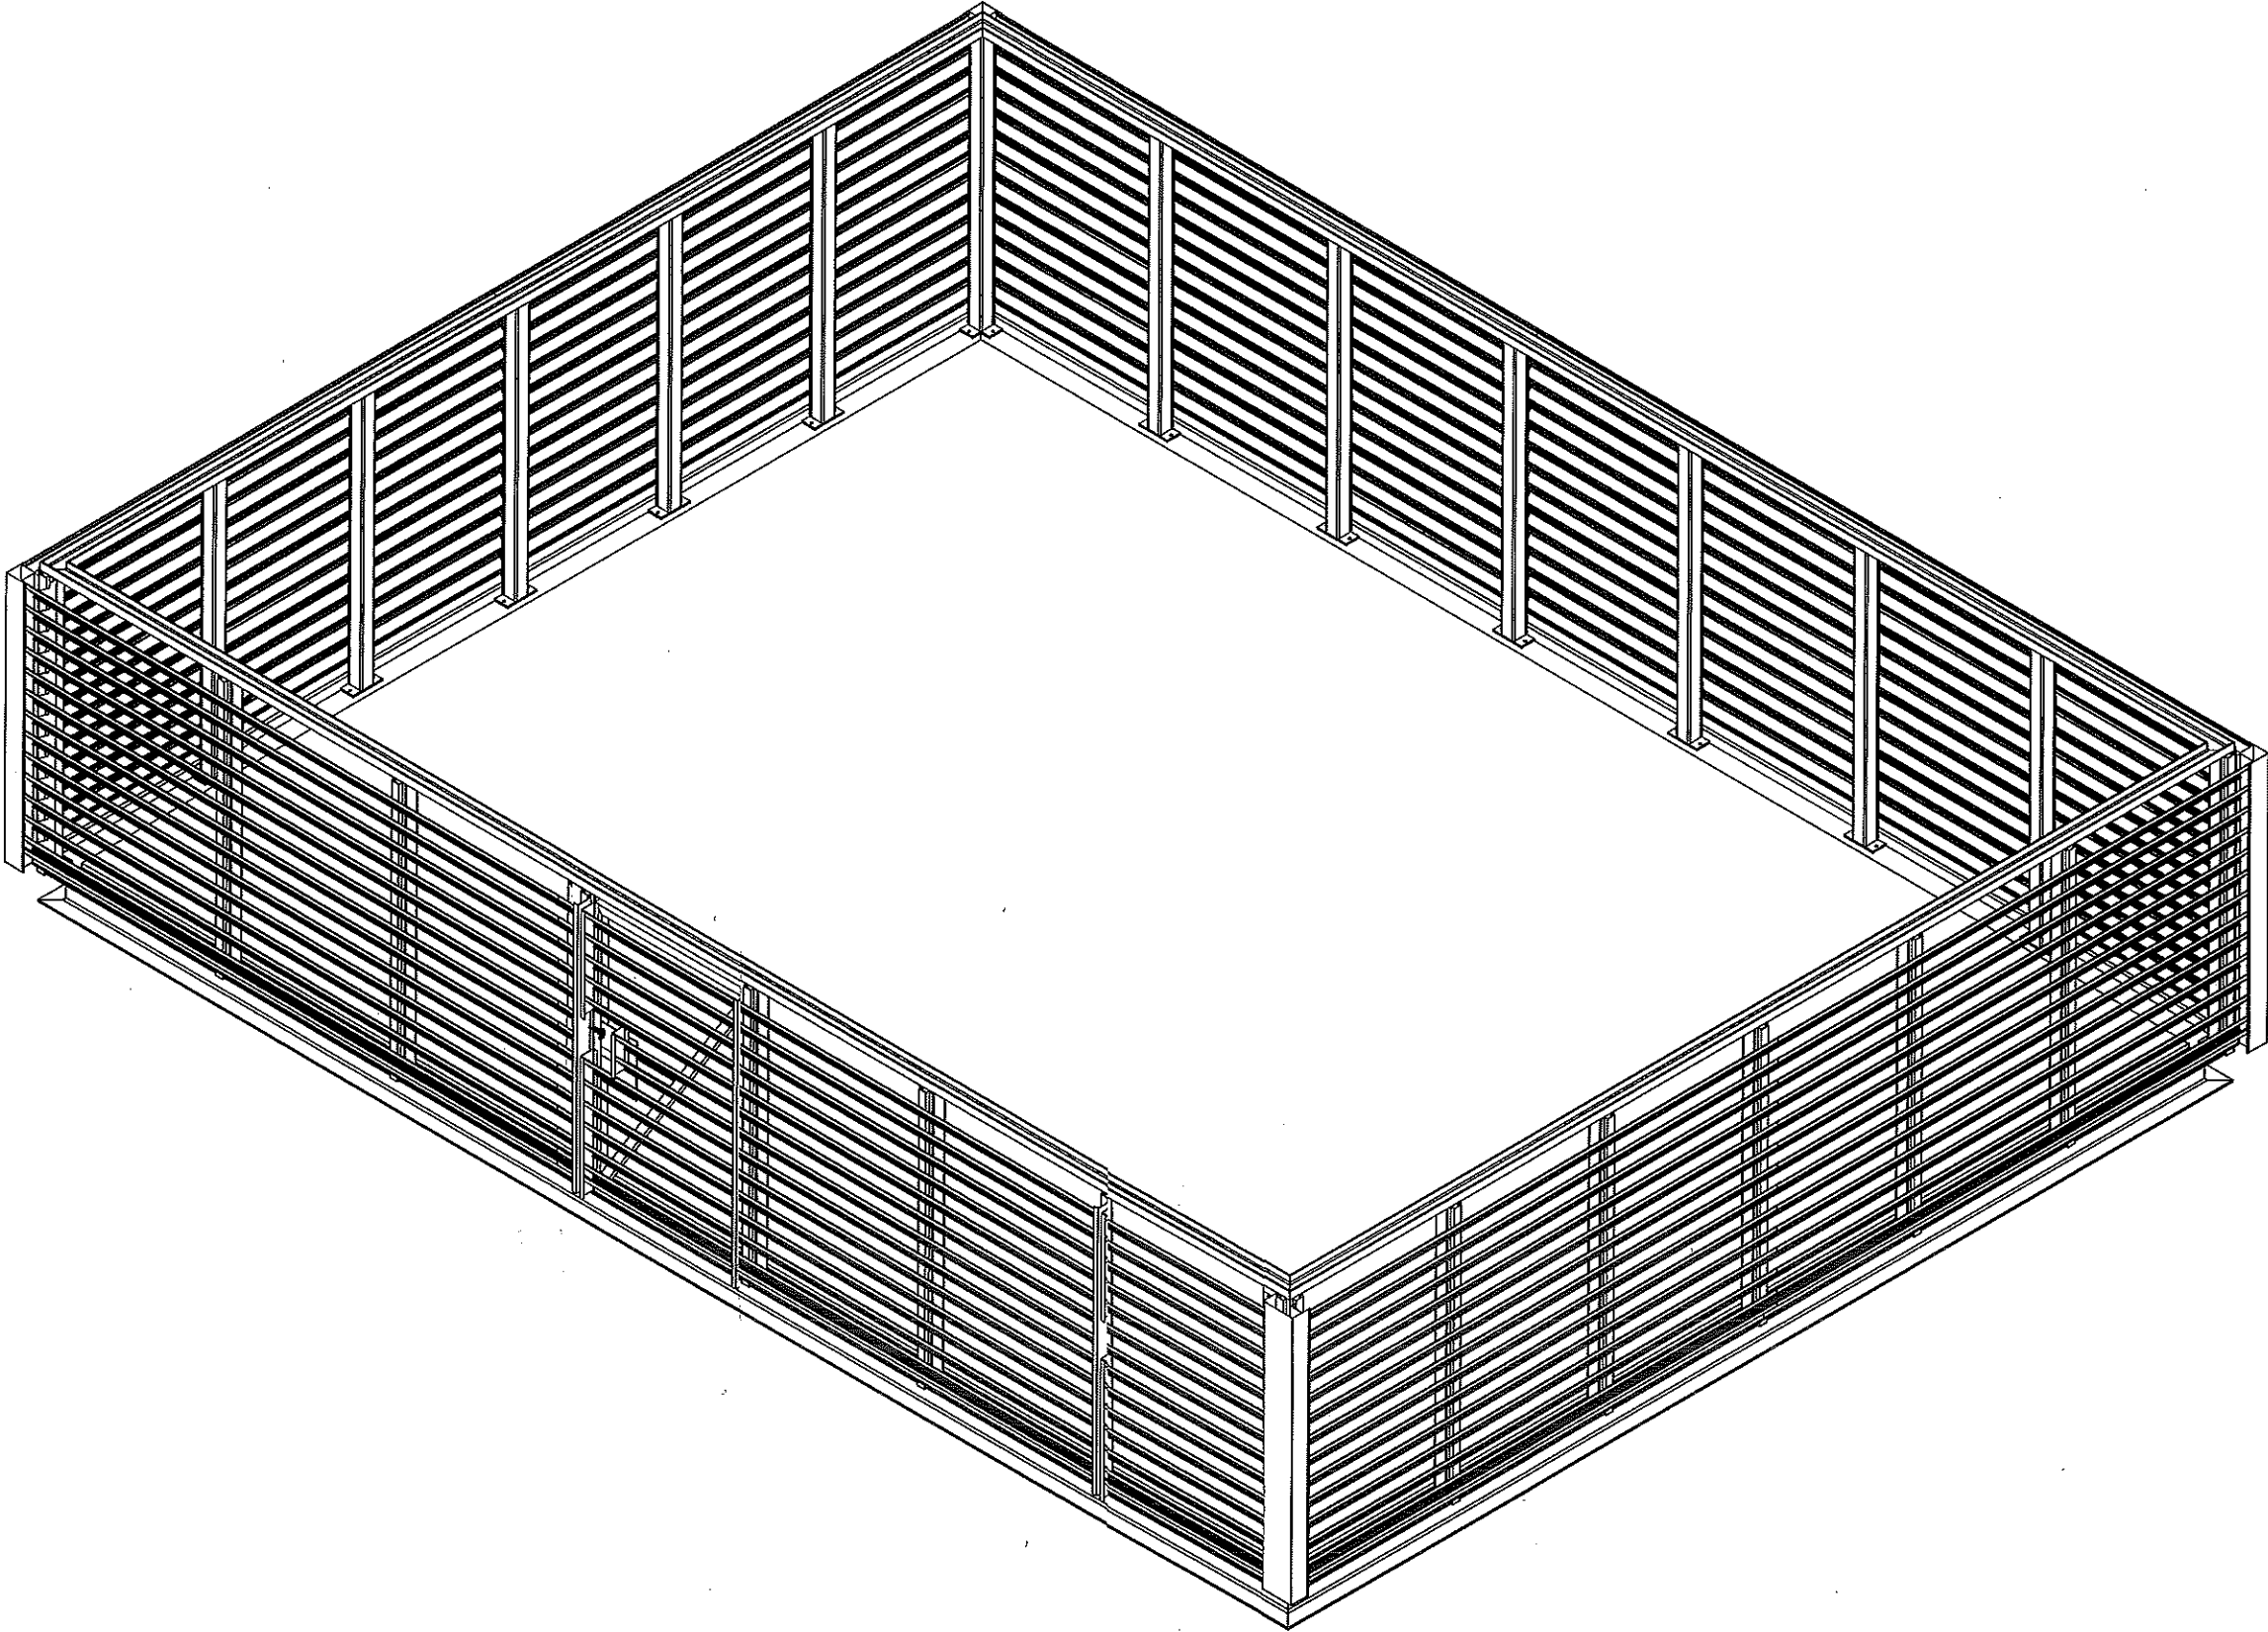

ISO VIEW (NTS)

TOLERANCES UNLESS OTHERWISE SPECIFIED			
FABRICATION		MACHINING	
DIM.	+/- 1	DIM.	+/- 0.05
ANGULAR	+/- 1°	ANGULAR	+/- 0.05°
HOLE CTRS.	+/- 0.5		

UNLESS SPECIFIED REMOVE ALL SHARP EDGES AND DEBURR ALL HOLES

ALL DIMENSIONS IN mm UNLESS OTHERWISE SPECIFIED MATERIAL CERTIFICATION CAN BE SUPPLIED ON REQUEST



11 WILLIAM STREET, BLACKSTONE
QUEENSLAND,
PO BOX 486 BOOVAL 4304,
PH- (07) 38165600

CLIENT:
BUXTON CONSTRUCTION

DRN BY: RH

DATE: 26/03/14

CKD BY: CM

DATE: -

PROJECT TITLE:
ASSISI



SCALE: 1:100

SHEET 2 OF 2

DRAWING TITLE:
PLANT ROOM SCREEN-
INVERTED VARSITY

FINISH REQUIRED.
COLORBOND - COTTAGE GREEN

DWG NO. 12280-01
PRODUCT ID. 20
REV. A

SIZE
A3