



Client	J.B.K.	Contact	Steve	Drawn by	N.R.	Date	02/06/14	Rev. no.	2
ASSISI CENTRE 230 ROSANNA ROAD, ROSANNA				MSSB 8 Page 8 of 11 As Built					
D.C Temperature Controls				Email d.p.duncan@bigpond.com PH 0412 389 460					



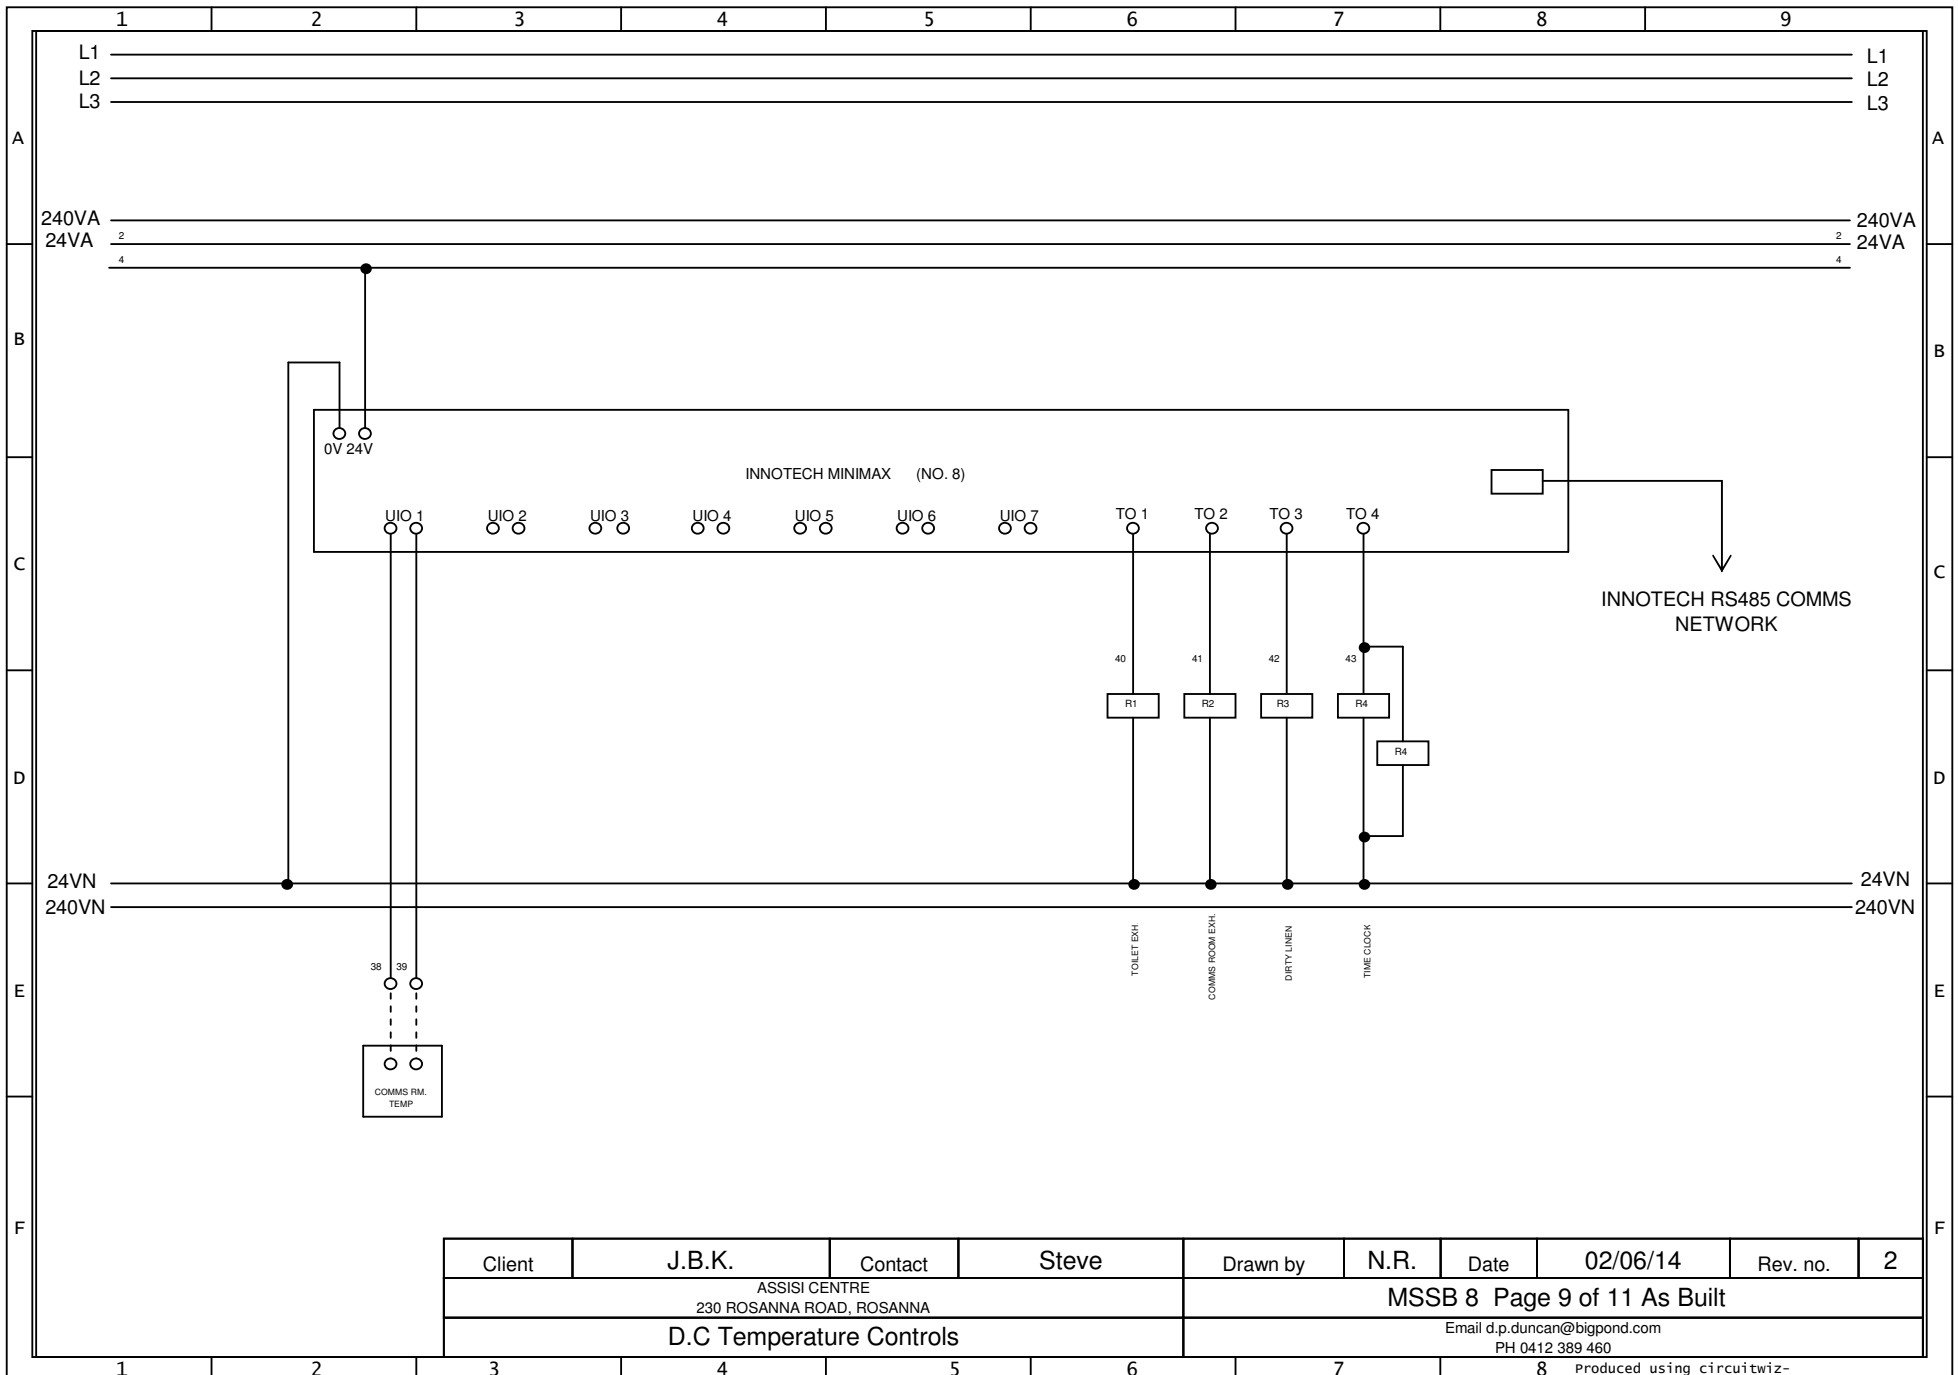

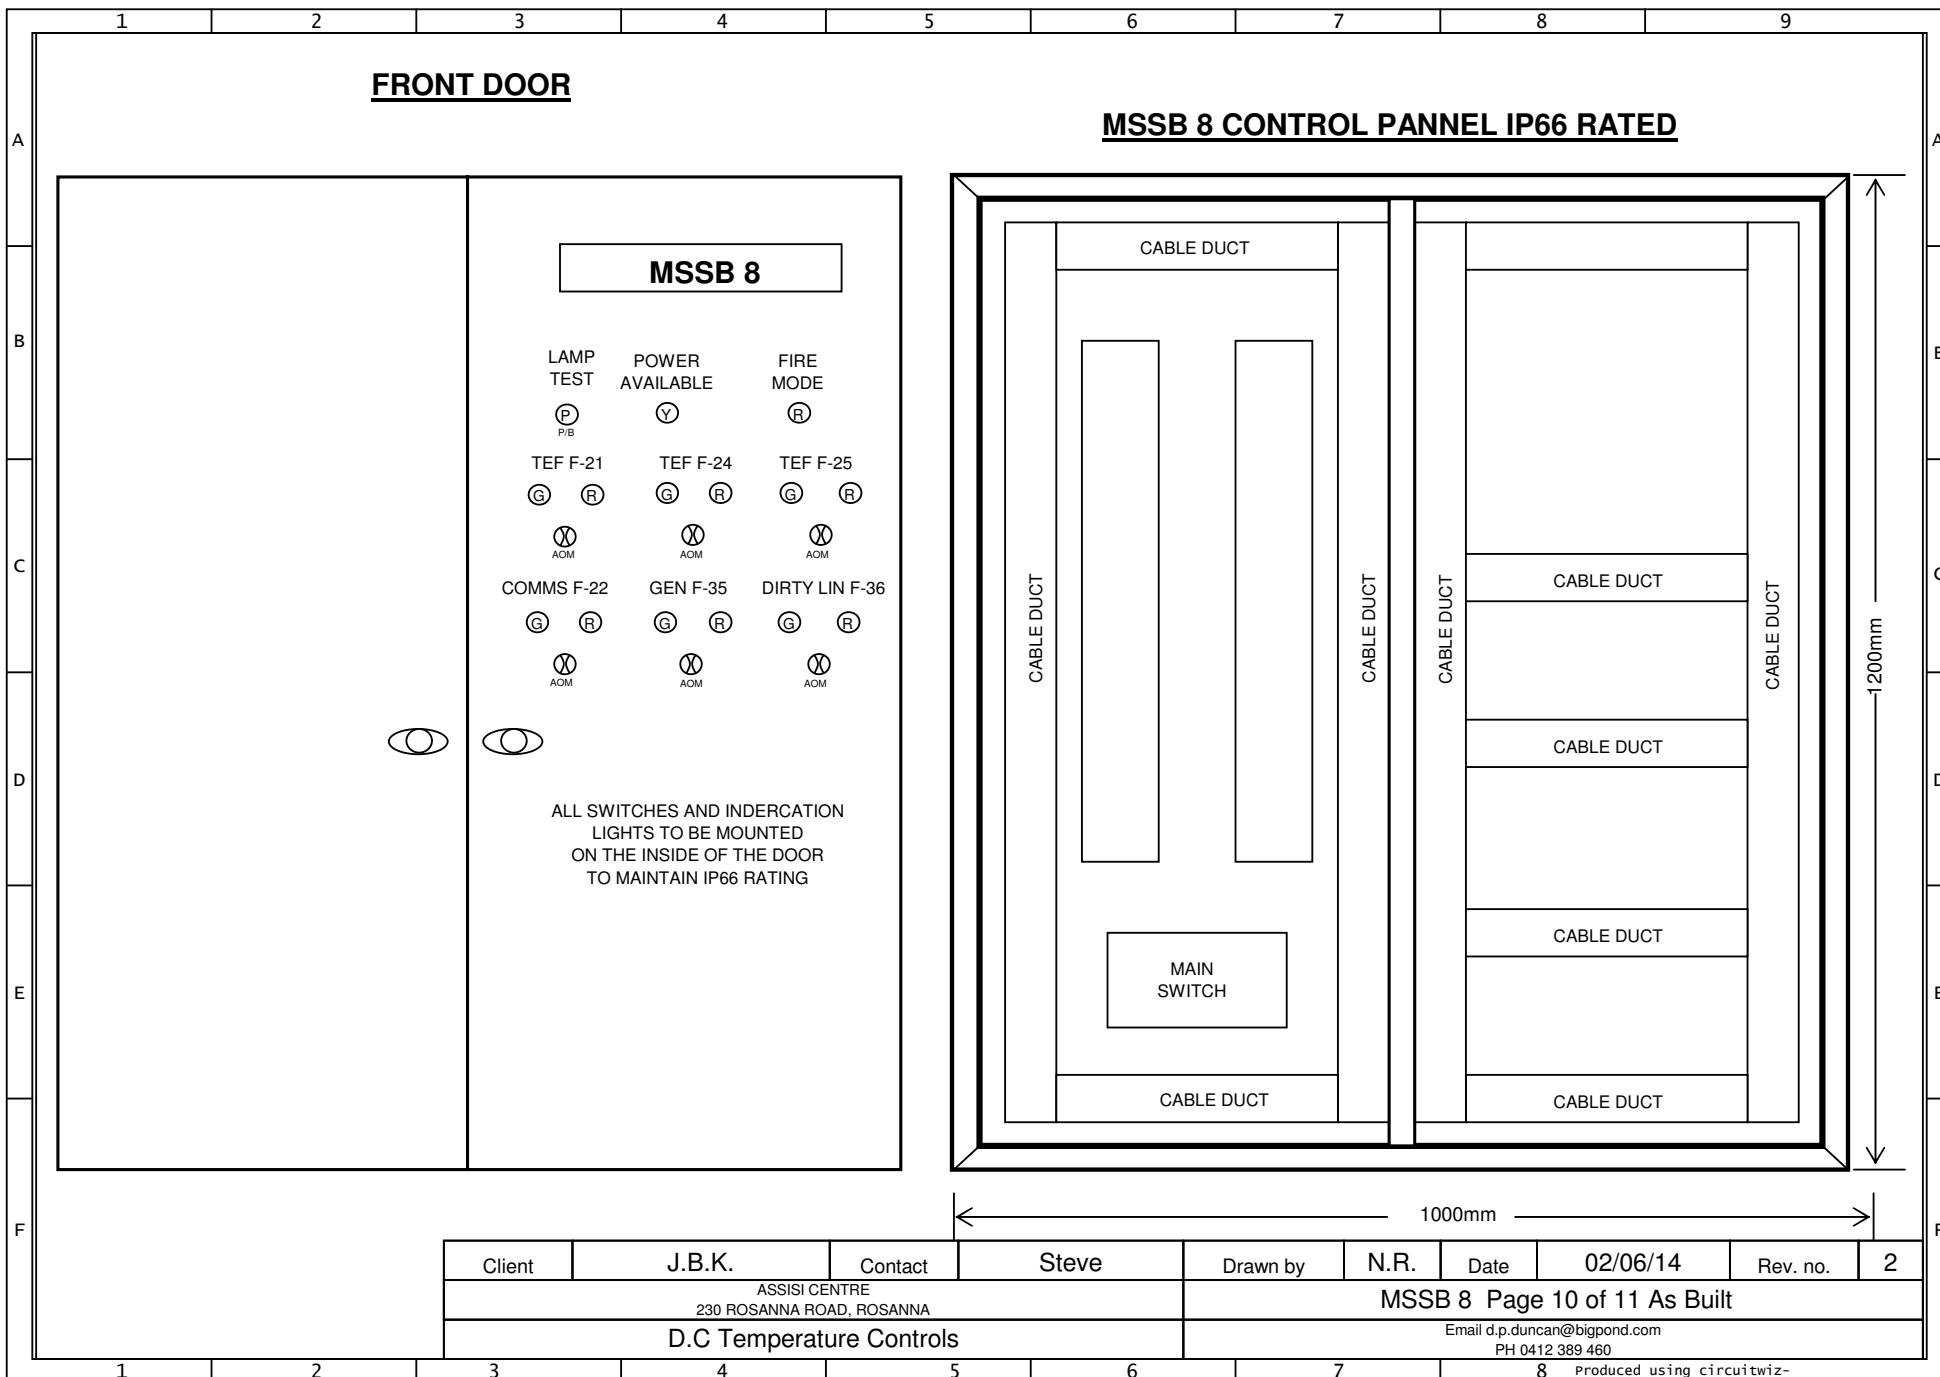

	1	2	3	4	5	6	7	8	9									
A	EQUIPMENT SCHEDULE																	
B	MAIN ISOLATOR			C&S CSSD400D1 24KA														
	PHASE FAILURE CONTROLER			TIGER TIG-RSTC														
	KILOWATT HOUR METER			TIGER TPKWH-100D														
	CIRCUIT BREAKER			MOELLER														
	CONTROL TRANSFORMER			ALTRO														
	CONTROL RELAYS			TIGER														
	CONTROL SWITCH'S			MOELLER														
C	PILOT LIGHTS			DDN AUSTRALIA PL22-22BS														
	LAMP TEST			TIGER LT-20														
	DDC			INNOTECH MINIMAX														
	SPEED DRIVES			VA2.0 & VA2.8 POT														
	SWITCH BOARD			EUREKA EEST8-1230														
D																		
E																		
F																		
	Client			J.B.K.		Contact		Steve		Drawn by		N.R.	Date	02/06/14		Rev. no.	2	
	ASSISI CENTRE 230 ROSANNA ROAD, ROSANNA									MSSB 8 Page 11 of 11 As Built								
	D.C Temperature Controls									Email d.p.duncan@bigpond.com PH 0412 389 460								
	1	2	3	4	5	6	7	8	Produced using circuitwiz-									

Client	J.B.K.	Contact	Steve	Drawn by	N.R.	Date	02/06/14	Rev. no.	2
ASSISI CENTRE 230 ROSANNA ROAD, ROSANNA				MSSB 8 Page 11 of 11 As Built					
D.C Temperature Controls				Email d.p.duncan@bigpond.com PH 0412 389 460					