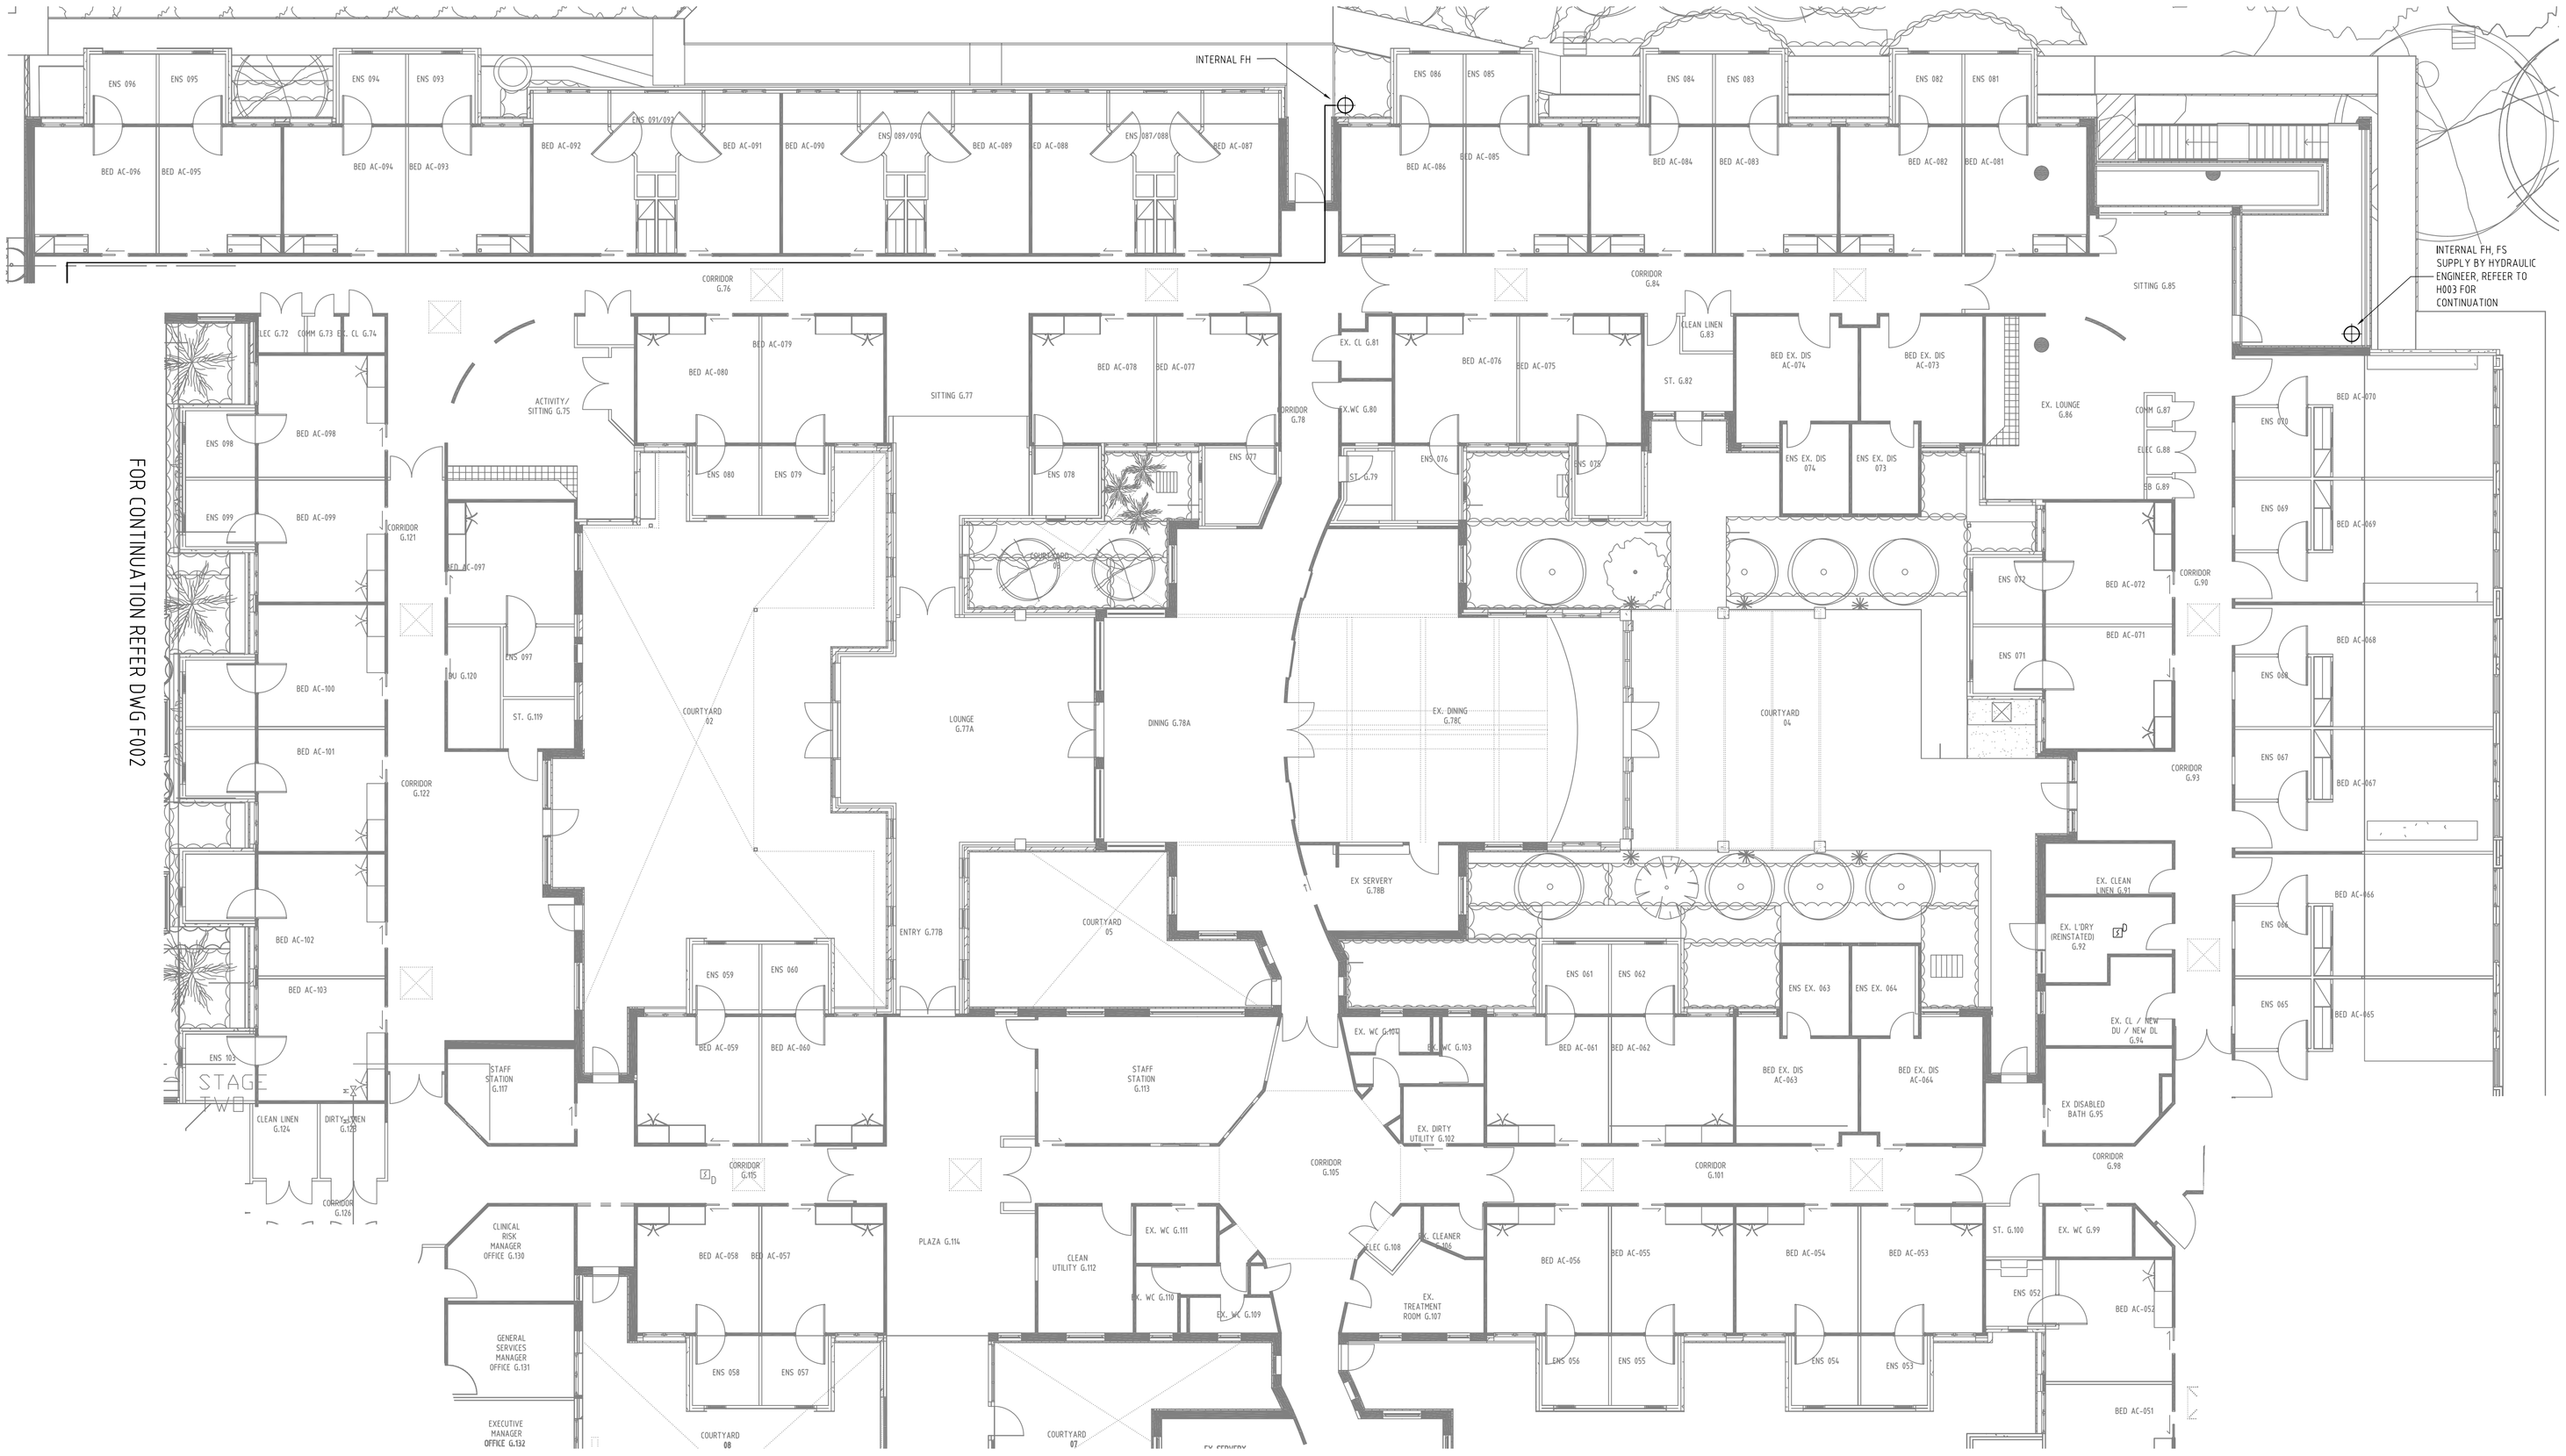

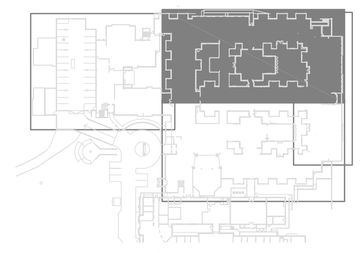

KEY PLAN

No	DATE	REVISIONS	BY
A	27.11.12	AS INSTALLED	AT

PLUMBCO PLUMBERS
A.B.N 91 097 699 226 LIC 33542
PLUMBCO PLUMBERS PTY LTD PHONE - 9646 7330
PO BOX 299 FAX - 9646 1927
PORT MELBOURNE VIC 3207 admin@plumbcoplumbers.com.au

PROJECT

SAINT FRANCIS OF ASSISI

230 ROSANNA ROAD
ROSANNA

TITLE

FIRE PROECTION SERVICES

GROUND FLOOR
SHEET 2

DATE	DRAWN	CHECKED	SCALE
27.11.12	AT	GS	B1 = 1:100
JOB No	DRAWING No		REV.
P-12-005	F003		A