HEIGHT SAFETY SPECIALISTS
Roofsafe Industrial Safety
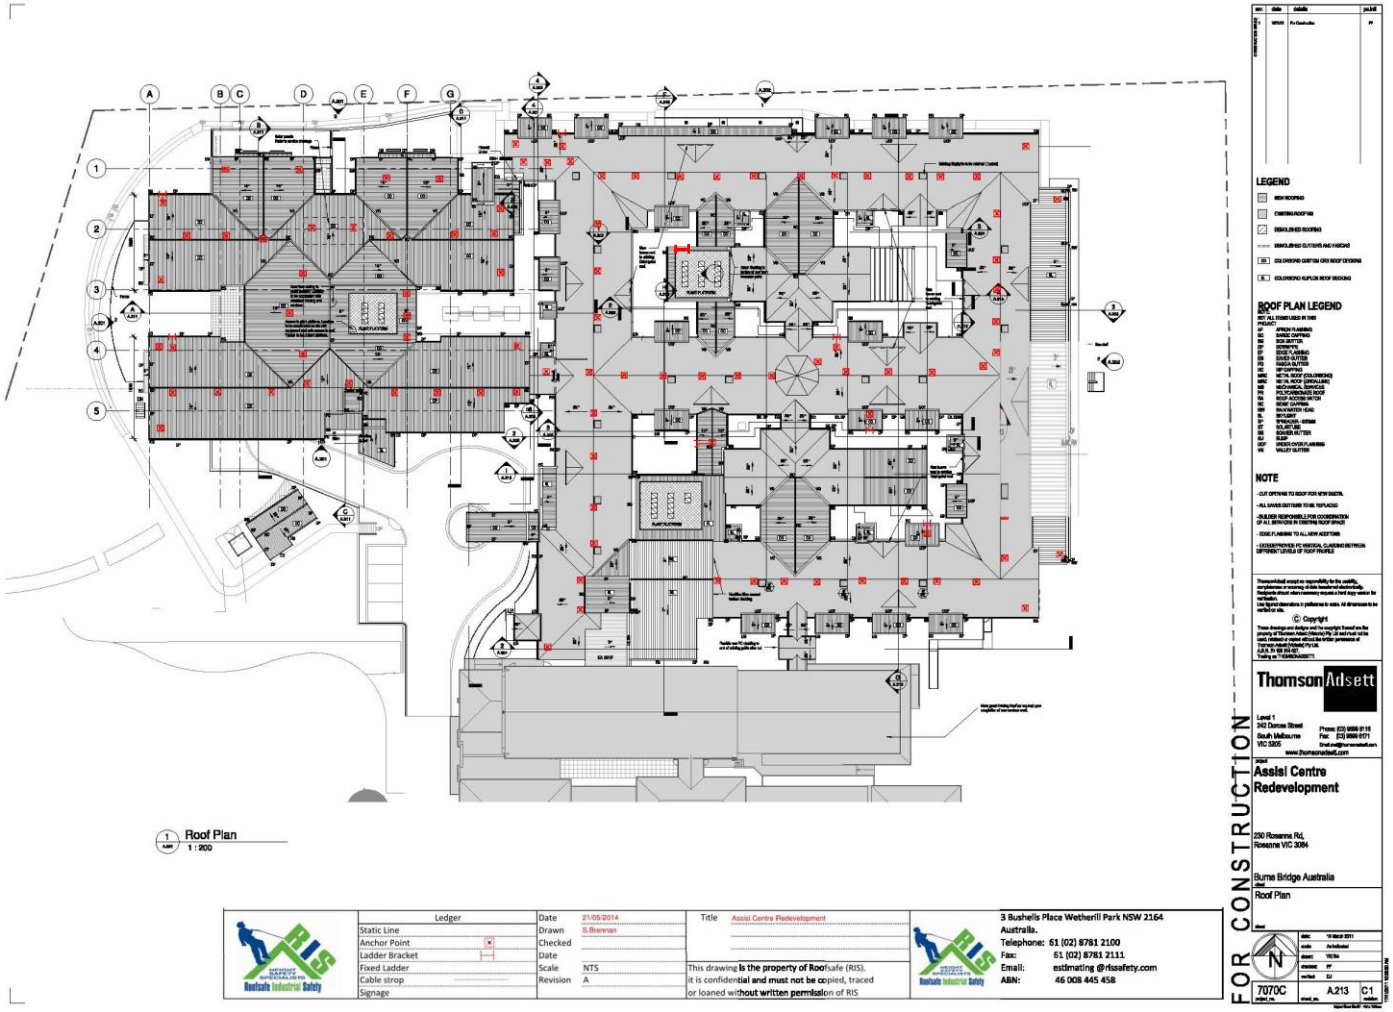
System Layout Plan