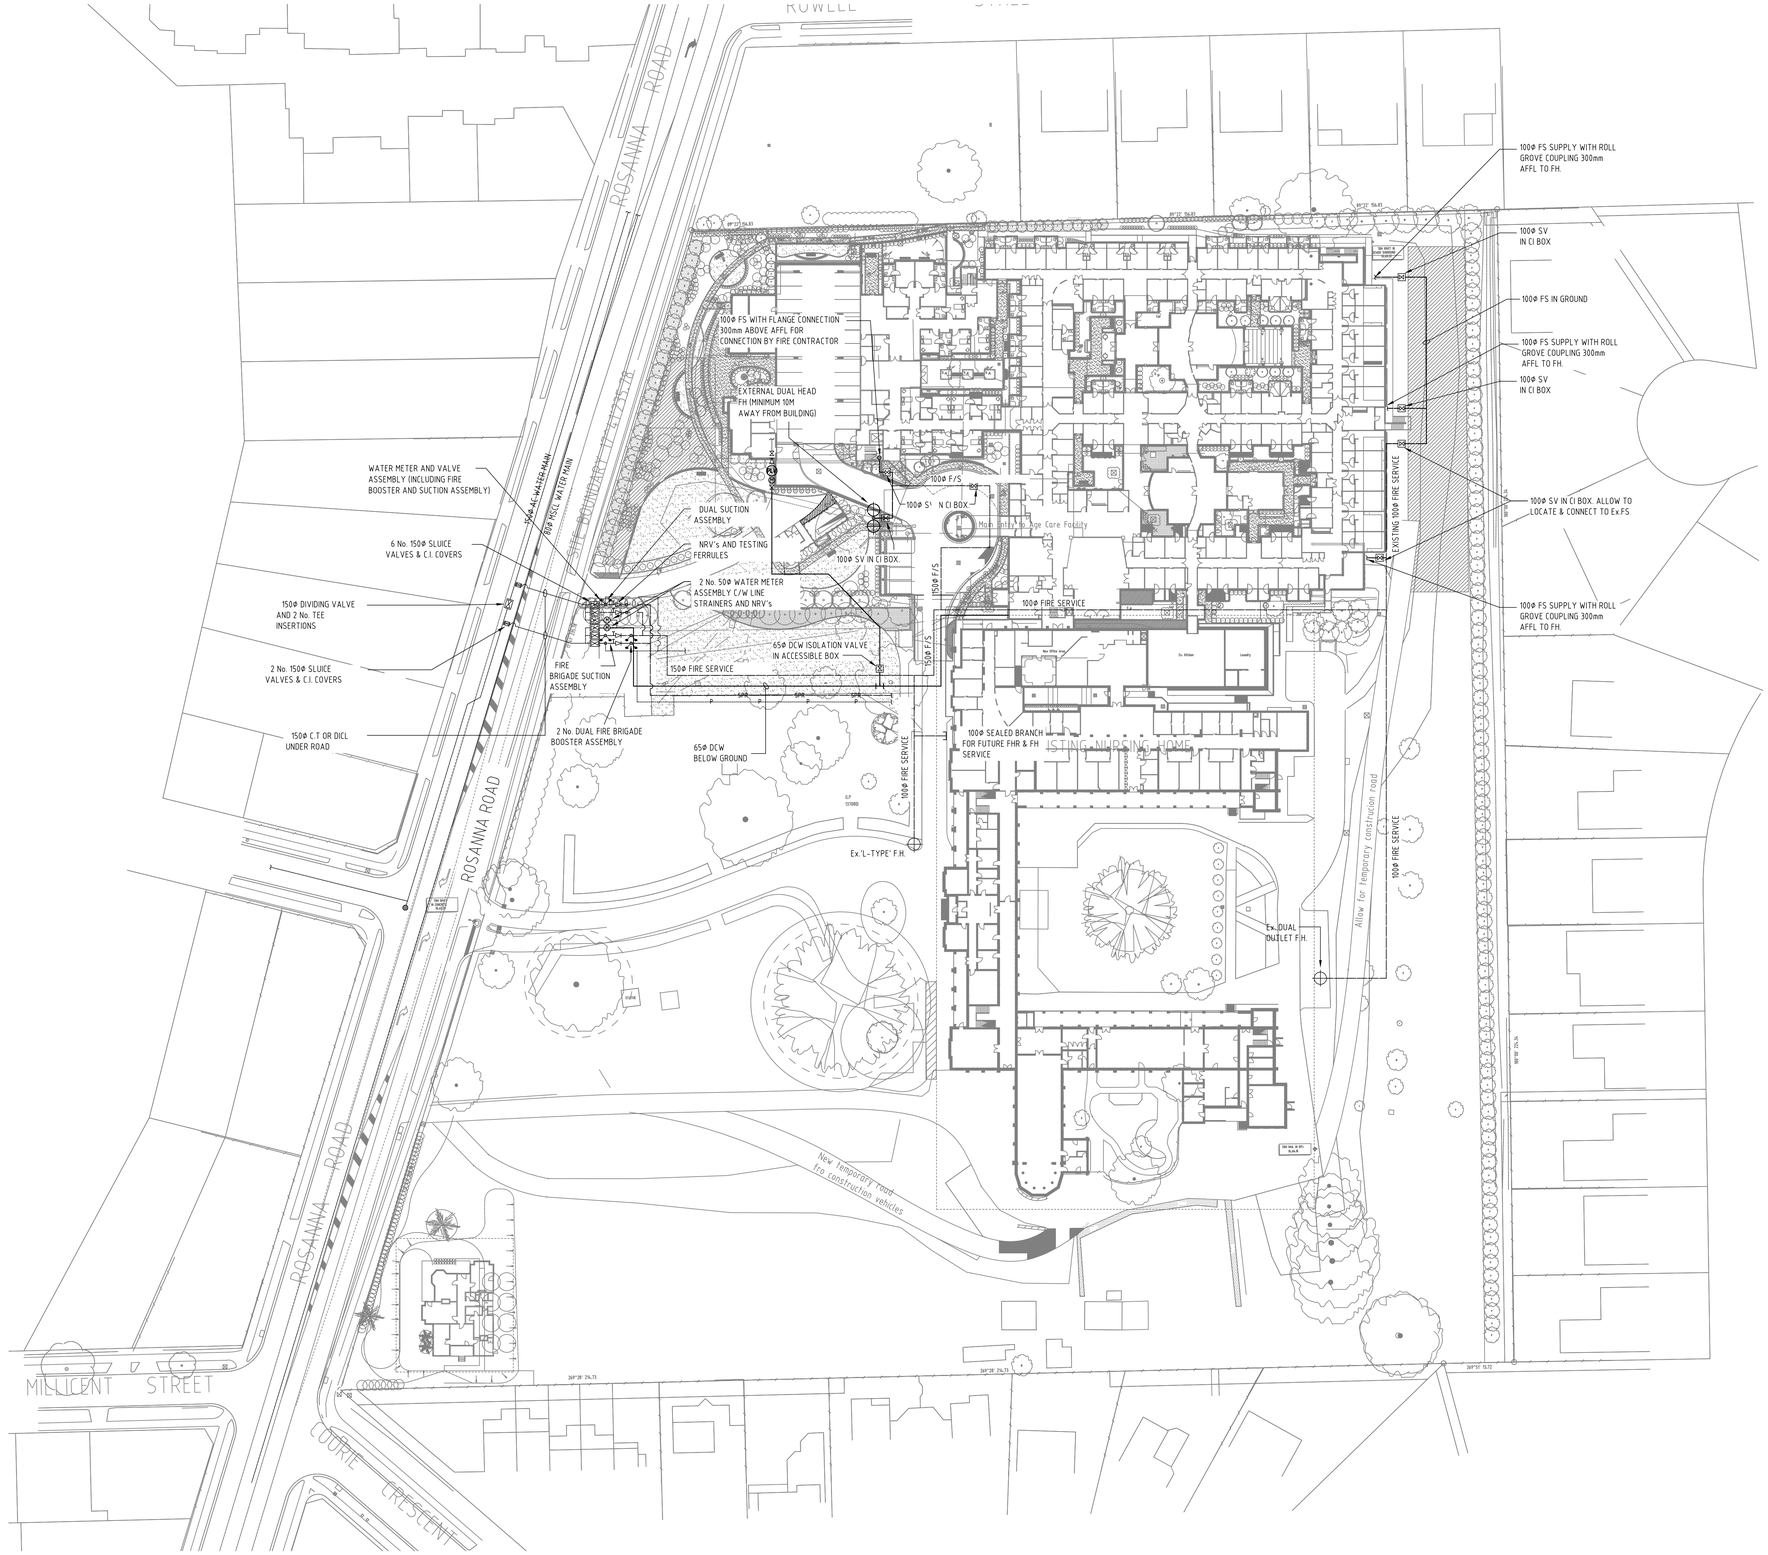

No	DATE	REVISIONS	BY
B	16.4.13	As Installed Revised	JB
A	27.11.12	AS INSTALLED	AT

PLUMBCO PLUMBERS
A.B.N 91 097 699 226 LIC 33542
PLUMBCO PLUMBERS PTY LTD
PO BOX 299
PORT MELBOURNE VIC 3207
PHONE - 9646 7330
FAX - 9646 1927
admin@plumbcoplumbers.com.au

PROJECT

SAINT FRANCIS OF ASSISI

230 ROSANNA ROAD
ROSANNA

TITLE

HYDRAULIC SERVICES

WATER AND FIRE HYDRANT SERVICES
SITE PLAN

DATE	DRAWN	CHECKED	SCALE
27.11.12	AT	GS	B1 = 1:500

JOB No	DRAWING No	REV.
P-12-005	H003	B